

WATER SERVICE RECORD

1101

Service No. 88

Name Robert L. Johnson

Address 12 Burroughs Road

Location Lot 175 Sta. 11+27

Repair—Renewal—New Service

W.O. # 7403

Sum 11-62


| Date | Material | Amount | Total | Date | Material | Amount |
|---------|--------------------------------|--------|-------|----------|-----------------------------|--------|
| 10-2-62 | Labor | 3.30 | | 6-28-62 | Deposit | 50.00 |
| | 10% O.H. | .32 | 3.62 | 10-10-62 | | 4.24 |
| | 9' 3/4" Copper tubing @ .42 | 3.78 | 3.78 | | | 54.24 |
| | 1 brass coupling 3.00 | | 3.00 | | | |
| | PREVIOUS CHARGE | | 10.30 | 10-10-62 | Labor | 2.04 |
| 6/30/62 | Labor | 4.65 | | | 9' 3/4" Copper tubing @ .42 | 3.78 |
| | 10% O.H. | .47 | 5.12 | | 1 3/4" 2 way cock | 2.01 |
| | 72' 3/4" Copper Tubing @ .42 | 30.24 | 30.24 | | 1 Esc. 2 way | 6.90 |
| | 3 4/4" Cx 1/2 IWH Stop & Waste | 6.17 | 6.17 | | 1 3/4" 2 way cock | 6.99 |
| | 1 3/4" C3 Part Union | 2.41 | 2.41 | | | 99.00 |
| | PREVIOUS CHARGE | | 10.30 | 6/30/62 | 1 1/2 Straight Tailpiece | 50 |
| | | | 54.24 | | 1 1/2 Offset Tailpiece | 50 |
| | | | | | | 23.29 |

DATE _____

TOWN OF LEXINGTON — BOARD OF PUBLIC WORKS

WATER DIVISION

Sketch of Service Here

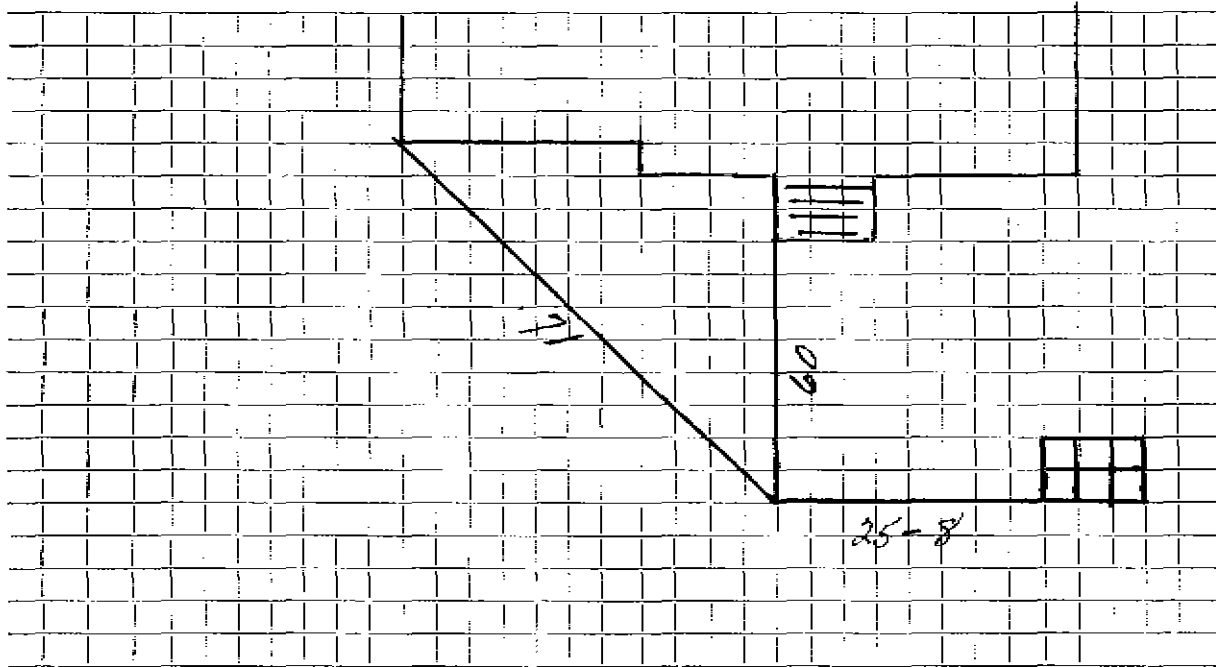

Connection made in Street. Work completed

Remarks:

.....
.....