

WATER SERVICE RECORD

1051
Service No. 310

Name Logan Clarke

Address 19 Burroughs Road

Location Lot #87 Sta. 9+95

6845

~~REPAIR~~ ~~REPAIR~~ - New Service

Conn 36-61


Date	Material	Amount	Total	Date		Amount
2-17-61	Labor	3.68		12-22-61	Deposit	75.00
	10% O.H.	.37	4.04	3-4-61	Retard	32.67
65'	3/4" Copper tubing @.42		27.30			42.93
1	3/4" C x 1/2" I.W.R. Stop & Waste		6.17		NO CHANGE	
1	3/4" C 3 part union		2.41	8-27-60	Labor	8.91
1	hr. Trucking @3.00		3.00	27'	3/4" Copper tubing @.42	11.34
			42.93	1	3/4" C Corp Cock	4.91
				1	3/4" C Curb Cock	6.28
				1	Box & Rod	4.90
						36.34
				1	3/8" Straight tailpiece	.50
				1	1/2" Offset tailpiece	.50
						37.34

DATE _____

TOWN OF LEXINGTON — BOARD OF PUBLIC WORKS

WATER DIVISION

Sketch of Service Here

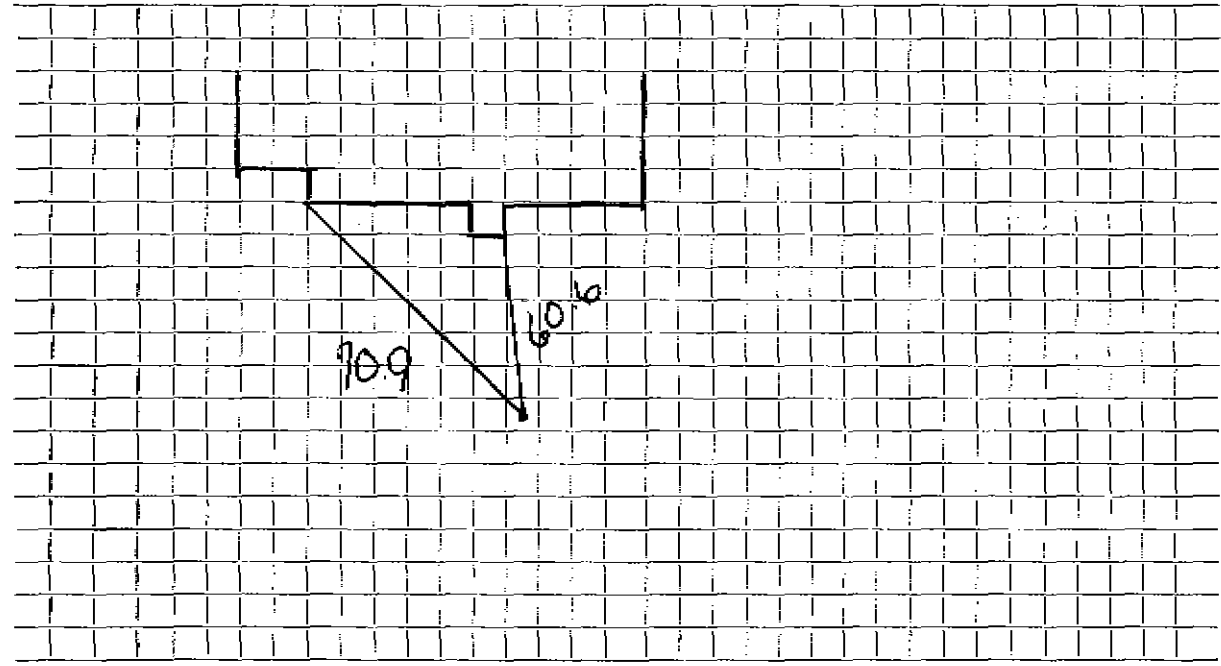

Connection made in Street. Work completed

Remarks:
.....
.....