

WATER SERVICE RECORD

#4908

Name Ralph Collozzo

Service No. 106

Address 20 Burroughs Road

Location Lot #76 Sta. 9+77

Repair—Renewal—New Service


Comm 9-25-61

Date	Material	Amount	Total	Date	Amount	
8-27-60	Labor	2.64		7-25-61	Deposit	25.00
	10% O.H.	.26	2.90	9-25-61	Refund	19.92
	8' 3/4" Copper tubing @.42		3.36			55.68
	1 hr. Trucking @3.00		3.00		NON CHARGE	
	BILL WHEN CONNECTED		9.26	8-27-60	Labor	3.30
8-12-61	Labor	4.40		10'	3/4" Copper tubing @.42	4.20
	10% O.H.	.44	4.84	1	3/4" C Corp Cock	4.91
	70' 3/4" Copper Tubing @.42		29.40	1	3/4" C Curb Cock	6.28
	1 3/4" c x 1/8 I.W.H. Stop & Waste		6.17	1	Box & Rod	4.90
	1 3/4" c 3 part union		2.41			23.59
	1 Hr. Trucking @3.00		3.00	1 1/8	Straight tailpiece	.50
			55.08	1 1/8	Offset tailpiece	.50
						24.59

TOWN OF LEXINGTON — BOARD OF PUBLIC WORKS

WATER DIVISION

Sketch of Service Here

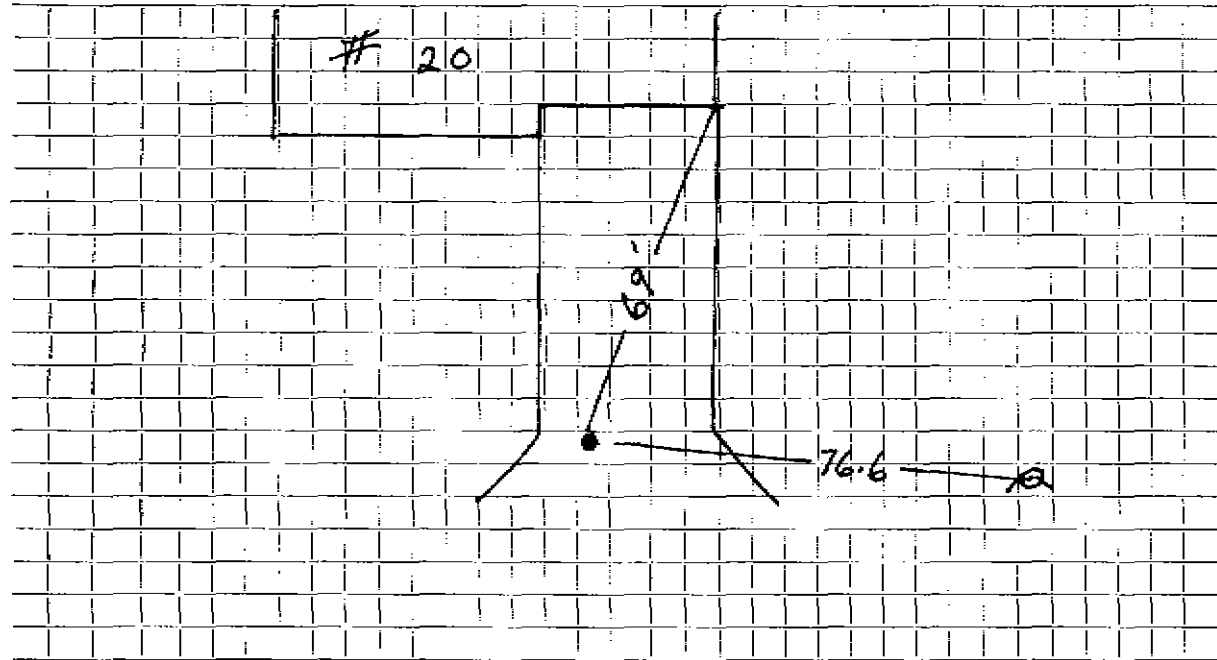

Connection made in Street. Work completed

Remarks:

.....

.....