

WATER SERVICE RECORD

Name Robert L. Johnson

Service No. 290

Address 21 Burroughs Road

1107

Location Lot #86 Sta. 8+38

~~Repair~~ ~~Renewal~~ New Service

Comm. 3-6-61


Date	Material	Amount	Total	Date		Amount
12-6-60	Labor	3.82		11-29-60	Deposit	50.00
	10% O.H.	.38	4.20	3-6-61	Retain	6.53
60'	3/4" Copper tubing @.42		25.20			43.47
1	3/4" C x 1/2 I.W.E. Stop & Waste		6.17		NON CHARGE	
1	Box & Rod		4.90	8-26-60	Labor	8.25
1	hr. Trucking @3.00		3.00		25' 3/4" Copper tubing @.42	10.50
			43.47		1 3/4" C Corp Cock	4.91
					1 3/4" C Curb Cock	6.28
					1 Box & Rod	4.90
						34.84
					1 1/2 Straight tailpiece	.50
					1 1/2 Offset tailpiece	.50
						35.84

DATE _____

TOWN OF LEXINGTON — BOARD OF PUBLIC WORKS

WATER DIVISION

Sketch of Service Here

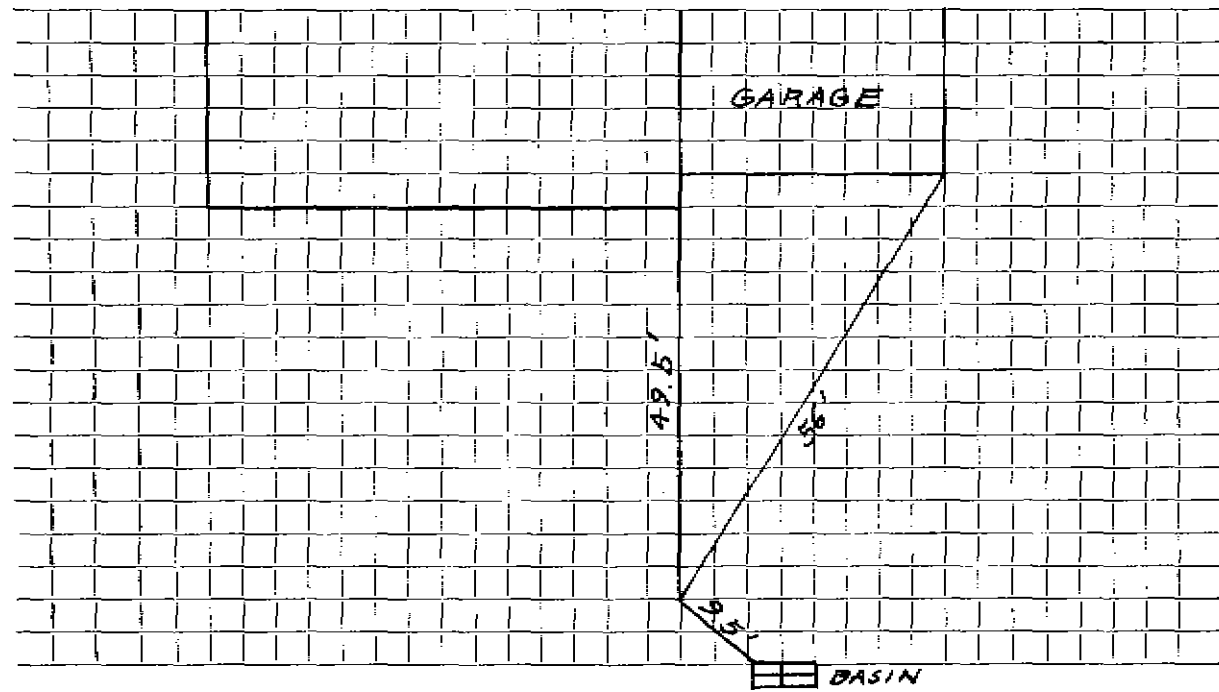

Connection made in Street. Work completed

Remarks:
.....
.....