
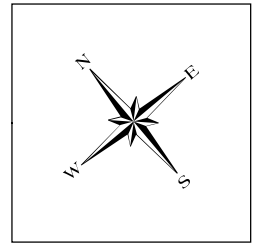


**Water Service Tie Card**  
**TOWN OF LEXINGTON**  
 MASSACHUSETTS

**22 Burroughs Road**

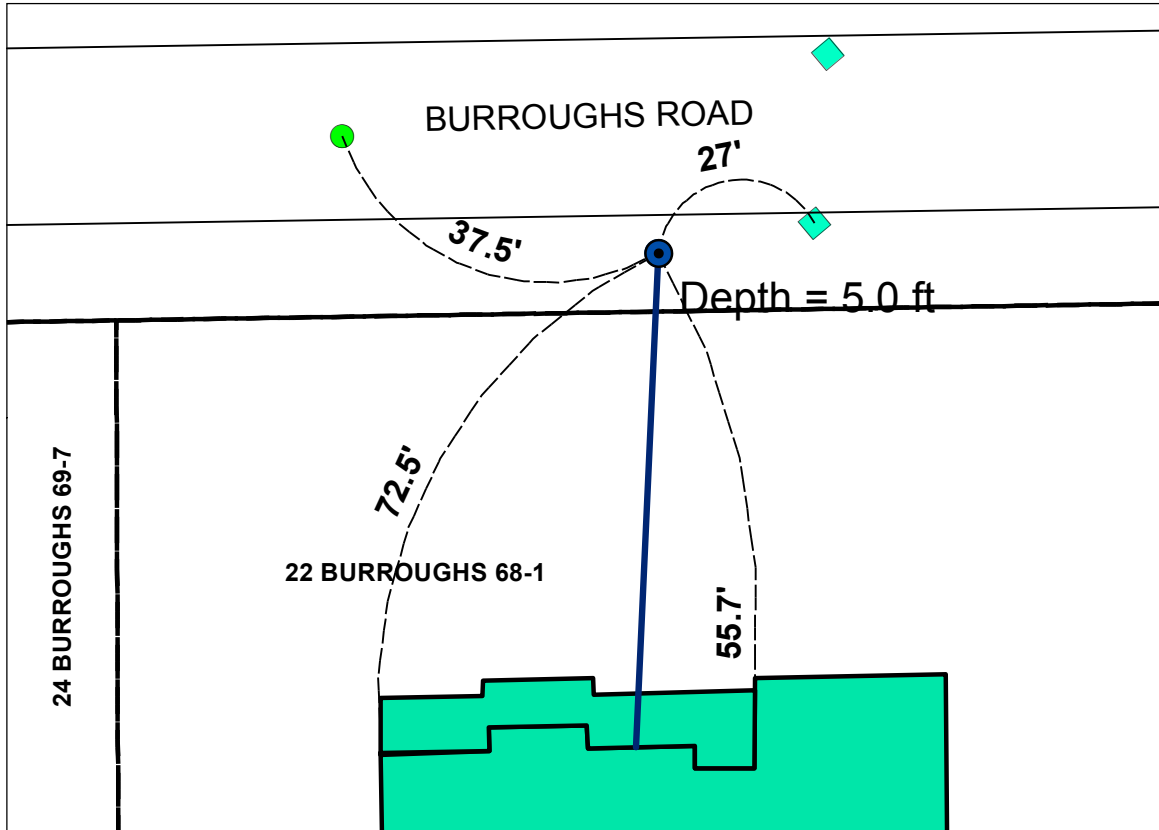

Legend	
<span style="color: blue;">●</span>	Curb Stop
---	Ties_Dimensions
<span style="color: blue;">—</span>	Water Service Line
---	Property Line
---	Edge of Pavement
<span style="color: green;">■</span>	CATCH BASIN
<span style="color: green;">●</span>	SMH

Address	Map and Lot	Permit Number	Contractor Name	Inspector
22 Burroughs Road	68-1	5480	Iovino	D. Pavlik

Date: 11/25/13	Material	Amount
	3/4" Copper type "k"	1 Foot
	3/4" to 1" fitting	1
	1" Copper type "k"	1 Foot
	1" Curb Valve and Buffalo Box	1
	1" Copper type "k"	63 Feet

**Type of work completed**  
 New 1" water service to house from curb stop. New house on lot old house removed.