

## WATER SERVICE RECORD

Name Emerson Realty Trust

Service No. 62

Address 23 Burroughs Road

Location Lot #85 Sta. 6+82

~~Repair or Extension~~ - New Service


Comm 7-17-61

Date	Material	Amount	Total	Date	Amount	
6-20-61	Labor	2.49		5-7-61	Deposit	60.00
	10% O.H.	.25	2.74	7-17-61	Refund	12.92
78'	3/4" Copper Tubing @.42		32.76			47.08
1	3/4" C X 1/2 I.W.H. Stop & Waste		6.17		NON CHARGE	
1	3/4" C 3 part union		2.41	8-26-60	Labor	7.26
1	Hr. Trucking @3.00		3.00	22'	3/4" Copper tubing @.42	9.24
			47.08	1	Box & Rod	4.90
				1	3/4" C Curie Cock	6.28
				1	3/4" C Corp Cock	4.91
						32.59
				6-20-61	1 1/2 straight tail piece	.50
					1 1/2 Offset tailpiece	.50
						33.59

DATE \_\_\_\_\_

**TOWN OF LEXINGTON — BOARD OF PUBLIC WORKS**  
**WATER DIVISION**

Sketch of Service Here

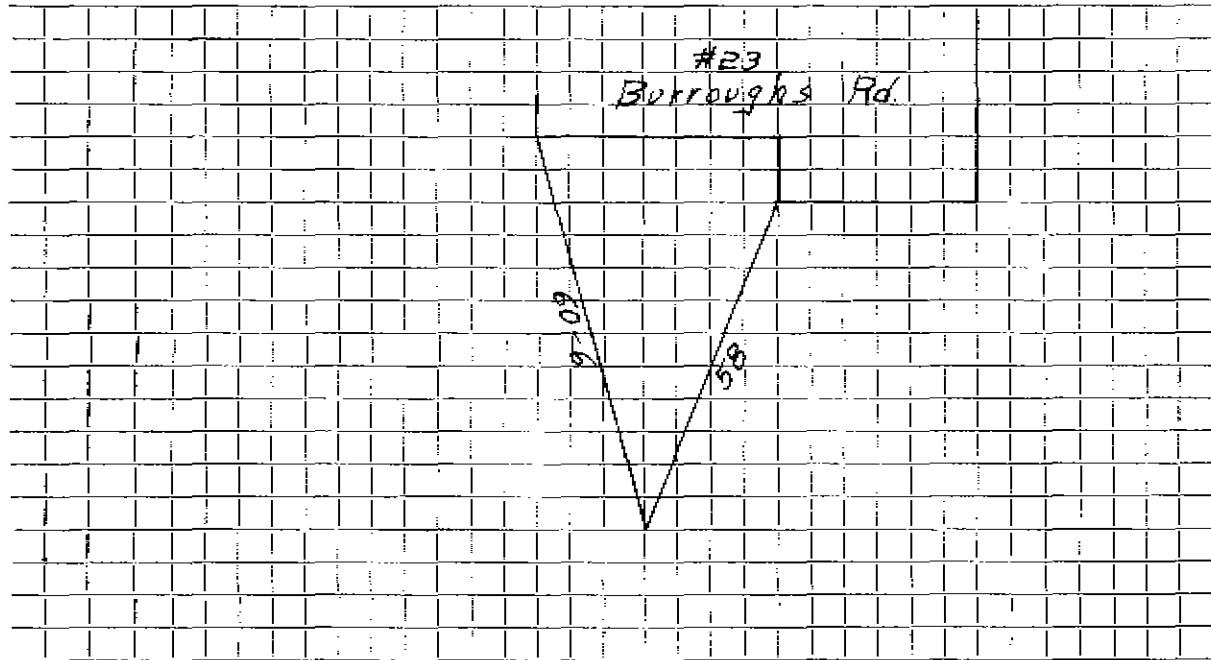

Connection made in ..... Street.      Work completed .....

Remarks: .....  
.....  
.....