

WATER SERVICE RECORD

Name Emerson Realty

Service No. 232

Address 24 Burroughs Road

Location Lot #78 Sta. 6+78

Repair—Renewal—New Service


Comm 11-30-60

Date	Material	Amount	Total	Date	Amount
8-27-60	Labor	1.94		11-13-60	50.00
	10% O.H.	.19	2.13	1-4-61	7.60
	3' 3/4" Copper tubing @.42		1.26		57.60
	1 Hr. Trucking @3.00		3.00		
	BILL WHEN CONNECTED		6.39		
				8-27-60	4.29
10-31-60	Labor	3 57		13' 3/4" Copper tubing @.42	5.46
	10% O.H.	36	3 93	1 3/4" C Corp Cock	4.91
	85' 3/4" Copper tubing @.42		35 70	1 3/4" C Gurb Cock	6.26
	1 3/4" Cx $\frac{1}{2}$ I.W.H. Stop Waste		6 17	1 Box & Rod	4.90
	1 Hr. Trucking @3.00		3 00		25.84
	1 3/4" C3 part Union		2 41	10-31-60	50
			57 60		50
					26 84

DATE _____

TOWN OF LEXINGTON — BOARD OF PUBLIC WORKS
WATER DIVISION

Sketch of Service Here

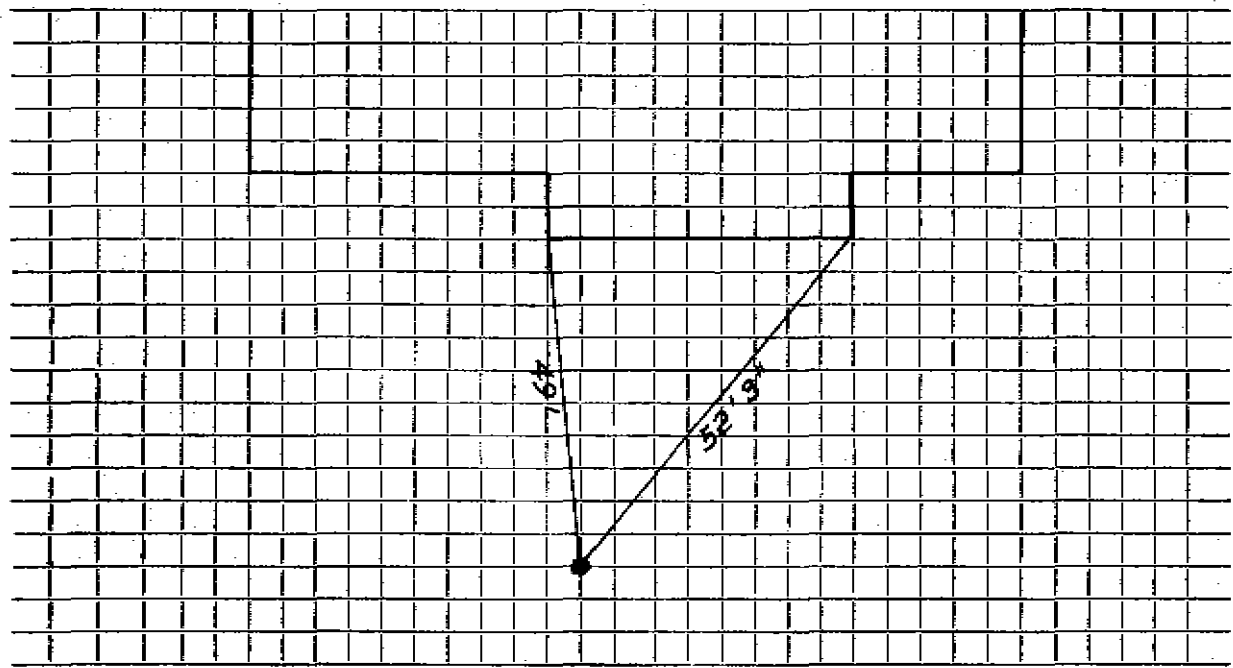

Connection made in Street. Work completed

Remarks:
.....
.....