

WATER SERVICE RECORD

Name Emerson Realty Trust

Service No. 10

Address 25 Burroughs Road

933

Location Lot #84 Sta. 5+29

~~Repair~~ ~~Renewal~~ ~~New Service~~

Comm 6-19-61


Date	Material	Amount	Total	Date	Material	Amount
4-18-61	Labor	2.36		3-10-61	Deposit	25.00
	10% O.H.	.24	2.60	1-19-61	Retard	27.32
	80' 3/4" Copper Tubing @.42		33.60			47.98
1	3/4" C X 1/2 I.W.H. Stop & Waste	6.17			NON CHARGE	
1	3/4" c 3 part union	2.41		8-26-60	Labor	7.68
1	Hr. Trucking @3.00	3.00		24'	3/4" Copper tubing @.42	10.08
			47.78	1	3/4" C Corp Cock	4.91
				1	3/4" C Curb Cock	6.28
				1	Box & Rod	4.90
						33.85
				1	1/2 Straight tailpiece	.50
				1	1/2 Offset tailpiece	.50
						34.85

DATE _____

TOWN OF LEXINGTON — BOARD OF PUBLIC WORKS

WATER DIVISION

Sketch of Service Here

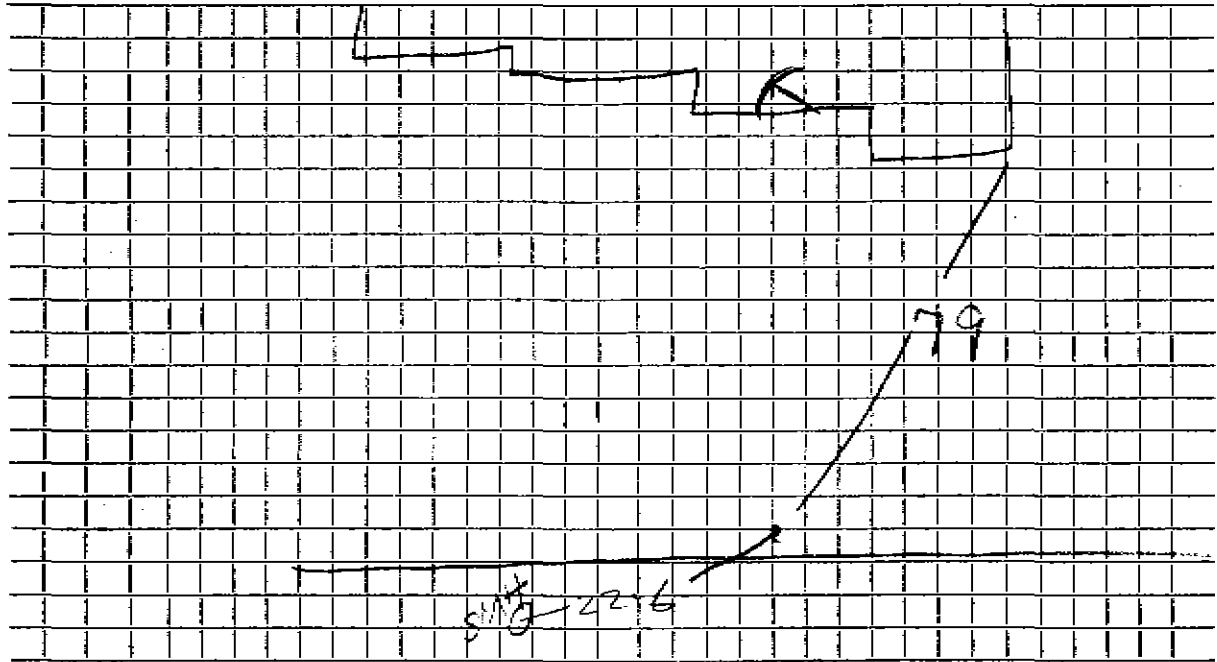

Connection made in Street. Work completed

Remarks:
.....
.....