




DATE 8/25/15

TOWN OF LEXINGTON — BOARD OF PUBLIC WORKS

WATER DIVISION

Sketch of Service Here

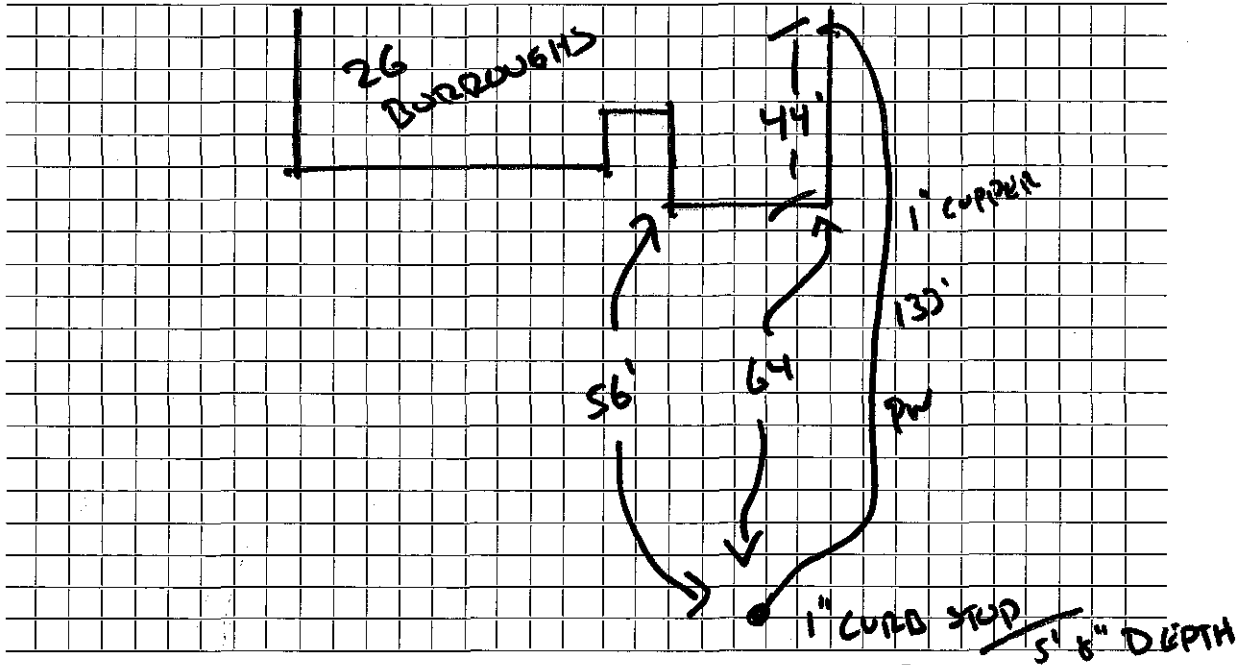

Connection made in BURROWS Street.

Work completed FINNEMAN

Remarks: .....

.....

.....