

WATER SERVICE RECORD

Name Emerson Realty Trust

Service No. 6

Address 27 Burroughs Road

7158

Location Lot #83 Sta. 3+76

~~Repair or Renewal~~ - New Service


P. 3-6-61

| Date | Material | Amount | Total | Date | | Amount |
|---------|-----------------------------------|--------|-------|---------|-------------------------|--------|
| 2-28-61 | Labor | 1.88 | | 1-20-61 | Deposit | 60.00 |
| | 10% O.H. | .19 | 2.07 | 3-6-61 | Refr. material | 12.25 |
| 80' | 3/4" Copper tubing @.42 | | 33.60 | | | 47.25 |
| 1 | 3/4" C x 1/2" I.I.H. Stop & Waste | | 6.17 | | NON CHARGE | |
| 1 | 3/4" C 3 part union | | 2.41 | 8-26-60 | Labor | 7.68 |
| 1 | hr. Trucking @3.00 | | 3.00 | 24 | 3/4" Copper tubing @.42 | 10.08 |
| | | | 47.25 | 1 | 3/4" C Corp Cock | 4.91 |
| | | | | 1 | 3/4" C Curv Cock | 6.28 |
| | | | | 1 | Box & Rod | 4.90 |
| | | | | | | 33.85 |
| | | | | 1 | 1/2" Straight tailpiece | .50 |
| | | | | 1 | 3/8" Offset tailpiece | .50 |
| | | | | | | 34.85 |

DATE _____

TOWN OF LEXINGTON — BOARD OF PUBLIC WORKS
WATER DIVISION

Sketch of Service Here

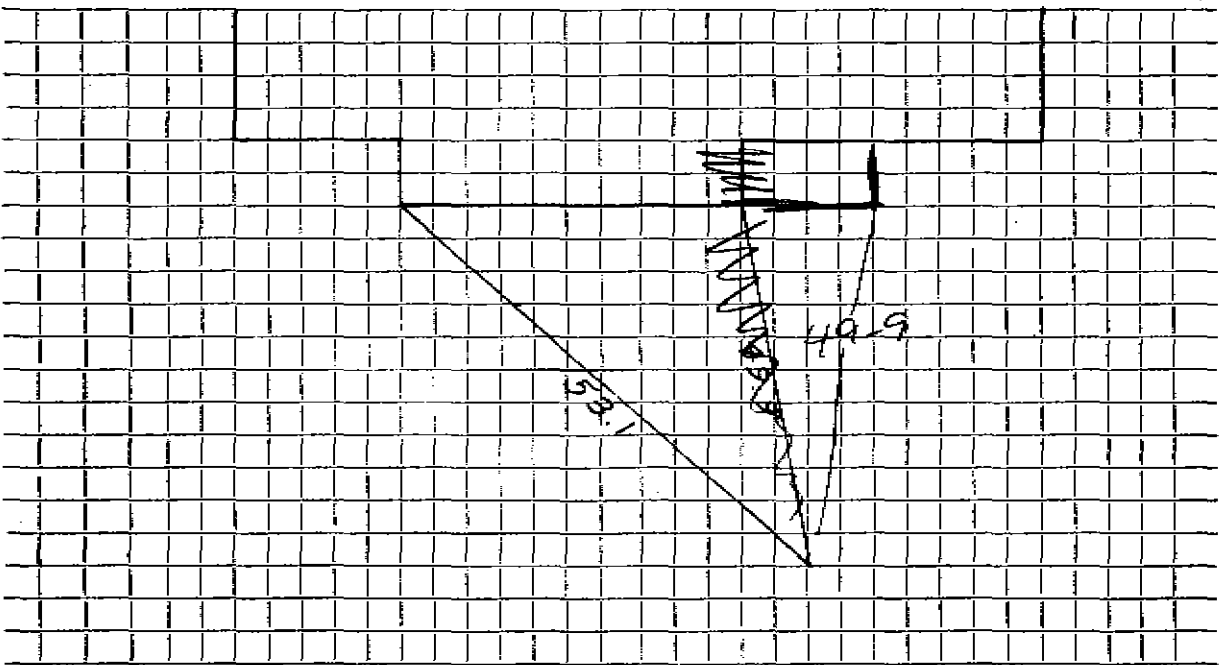

Connection made in Street. Work completed

Remarks:
.....
.....