


DATE _____

TOWN OF LEXINGTON — BOARD OF PUBLIC WORKS

WATER DIVISION

Sketch of Service Here

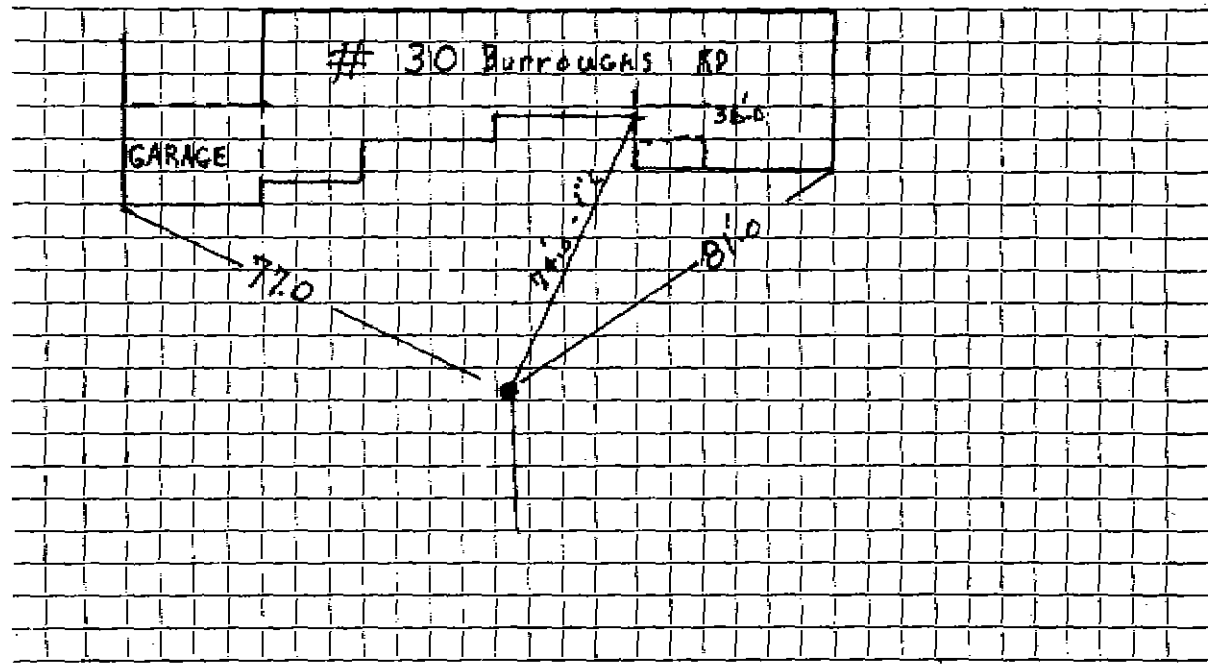

Connection made in Street. Work completed

Remarks:
.....
.....

ATTN:

Water & Sewer

teardown

pls update tie
cards as needed.

Thanks
Joanne



TOWN OF LEXINGTON
OFFICE OF SELECTMEN

3-4-03

Date

To David Rothfuchs

Under Article 6 section 2 of the General By-Laws of the Town of Lexington, it is ordered that "The Selectmen shall determine and designate numbers for the buildings abutting upon or adjacent to such streets or portions of streets as they may deem best for public convenience. No person shall neglect or refuse to affix to any building owned by him, the street number designated for him by said board."

The owner of the building on

Burrroughs Rd.
Street

69/3
Lot No.

is hereby notified that
the proper number is

31

BOARD OF SELECTMEN

By Peter Karalexis

changed from # 11 Thoreau Rd.