


**Water Service Tie Card**  
**TOWN OF LEXINGTON**  
 MASSACHUSETTS

**4 Burroughs Rd**

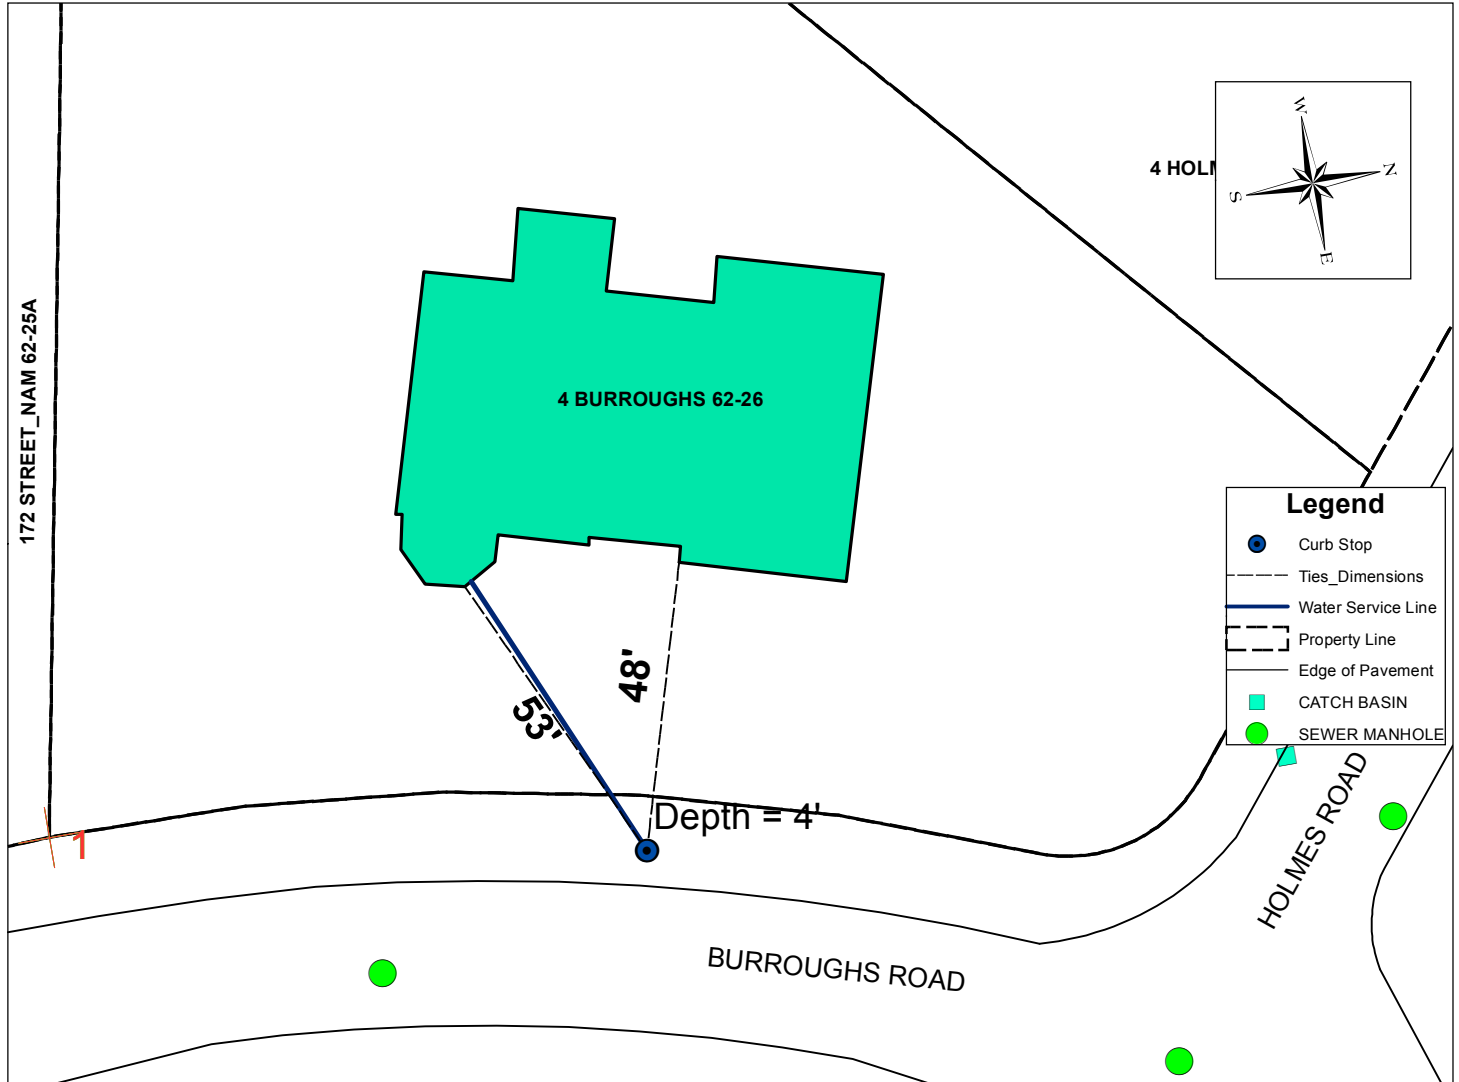

Address	Map and Lot	Permit Number	Contractor Name	Inspector
4 Burroughs	62-26	6048	J. W. Sullivan Corp.	msprague
Date	Material	Depth of Cover	Amount	
1/16/2015	3/4" Copper type "k"	4 ft	1 ft	
	3/4" to 1" fitting	4 ft	1	
	1" Copper type "k"	4 ft	1 ft	
	1" Curb Valve and Buffalo Box	4 ft	1	
	1" Copper type "k"	5 ft	56 ft	
Type of work completed				

New 1" water service to house from curb stop. New house on lot old house removed.