

WATER SERVICE RECORD

Name Michael Graziano

Service No. 84

Address 5 Burroughs Road

Location Lot 93 Sta. 18+25

~~Repair~~ ~~Renewal~~ New Service

W.O.# 8141


Comm 10-28-63

Date	Material	Amount	Total	Date		Amount
9-3-63	Labor	7 01		8-23-63	Deposit	50 00
	10% O.H.	70	7 71	10-28-63	Refund	2 99
66'	3/4" Copper Tubing @.42		27 72			47 61
1	3/4" CX $\frac{1}{2}$ I.W.H. Stop&Waste		6 17			
1	3/4" C3 Part Union		2 41		NON CHARGE	
1	Hr. Trucking @3.00		3 00	10-20-60	Labor	8 84
			47 01	25'	3/4" Copper tubing	10 50
				1	3/4" CCorp Cock	4 91
				1	3/4" C3urb Cock	6 28
				1	Box & Rod	4 90
						35 43
				9/3/63	1 $\frac{1}{2}$ Straight Tailpiece	50
					1 $\frac{1}{2}$ Offset Tailpiece	50
						36 43

TOWN OF LEXINGTON — BOARD OF PUBLIC WORKS

WATER DIVISION

Sketch of Service Here

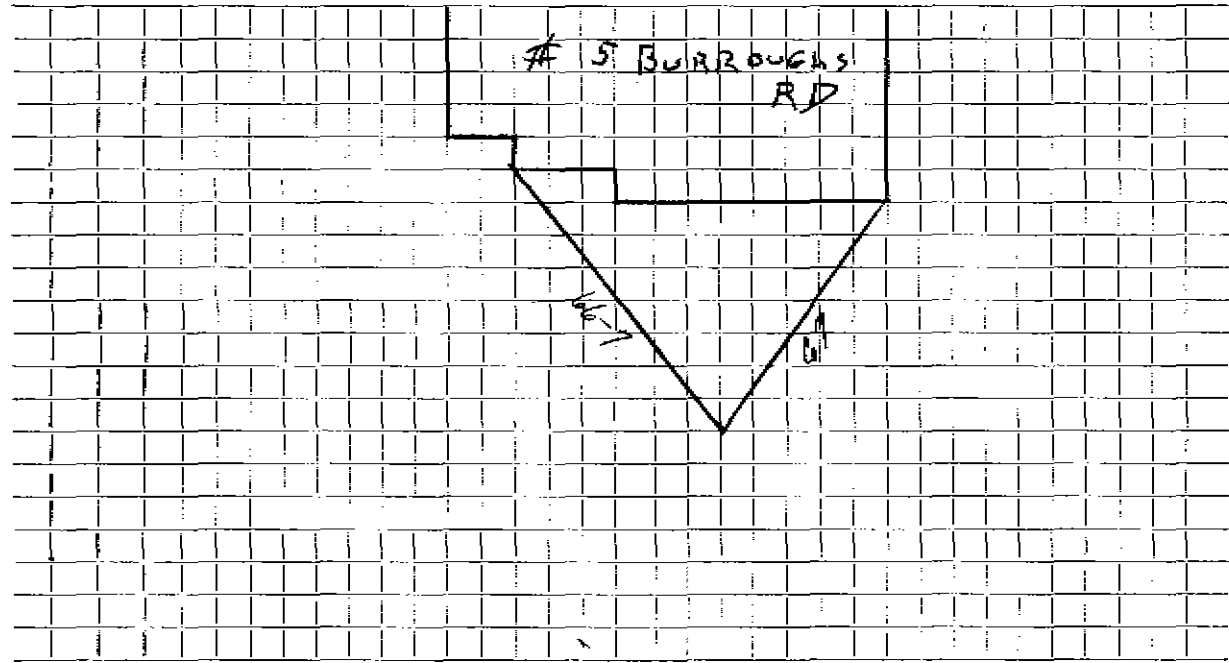

Connection made in Street. Work completed

Remarks:
.....
.....