




TOWN OF LEXINGTON — BOARD OF PUBLIC WORKS  
**WATER DIVISION**

Sketch of Service Here

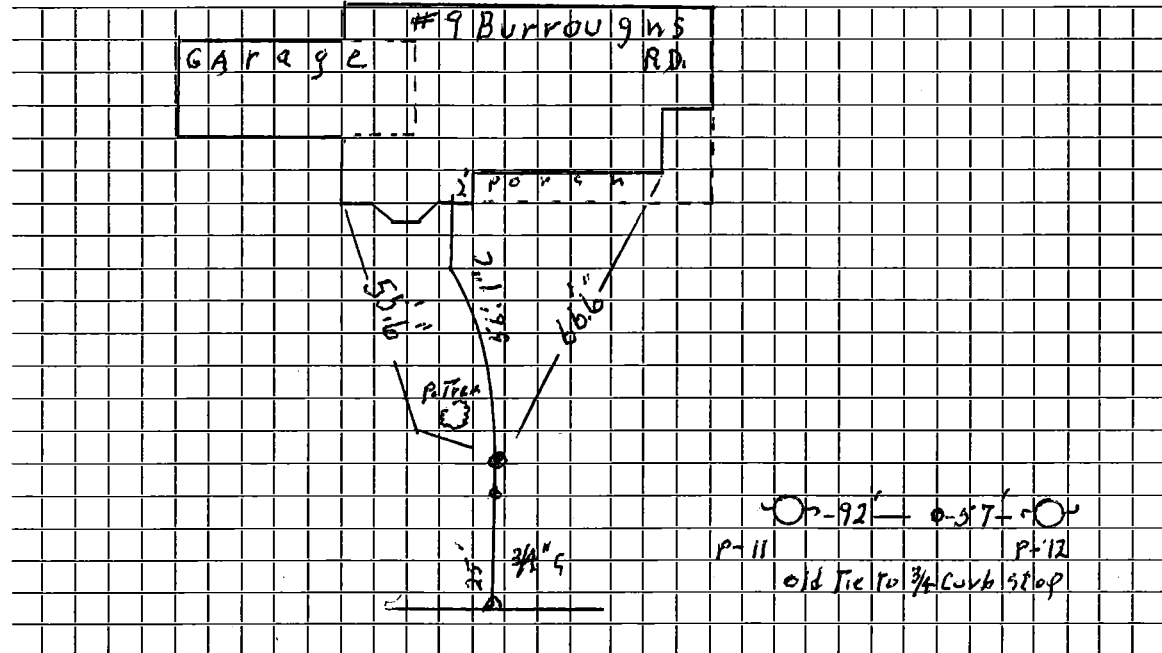

Connection made in ..... Street. Work completed *inside fl. 2/10 J. McL.*

Remarks: *Gas. Co. Relocated shut off. 1/2 IN. FRONT. OF 3/4\"/>*