


TOWN OF LEXINGTON — BOARD OF PUBLIC WORKS
WATER DIVISION

DATE _____

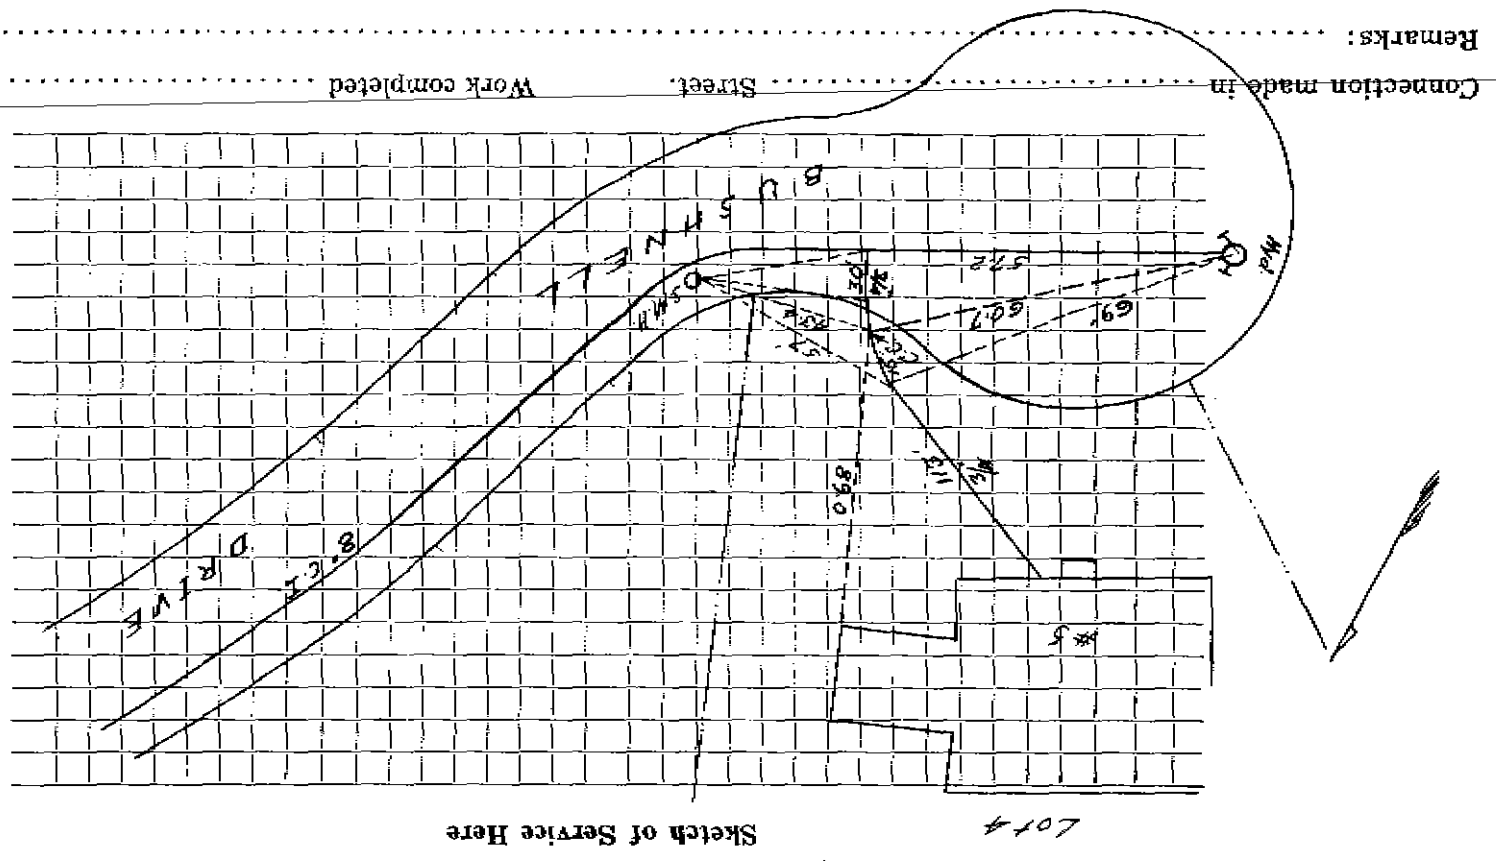

Remarks: _____

Street. Work completed _____