

## WATER SERVICE RECORD

Name

Service No.

Address 9 Bushnell Dr/Was 237 Waltham ST.

Location

Repair ~~Renewal~~ New Service Jim McLaughlin

Let 100 Waltham ST


Date	Material	Amount	Total	Date	outside	Amount
	1" Copper To house			4/1/71	20' 1" Copper	
					1 1" Corporation	
					1 1" Corb Lock	
					Box & Rod	
					P.I.-used frame & Rain cover	
					Was 4 Way branch	

DATE \_\_\_\_\_

TOWN OF LEXINGTON — BOARD OF PUBLIC WORKS

WATER DIVISION

Sketch of Service Here

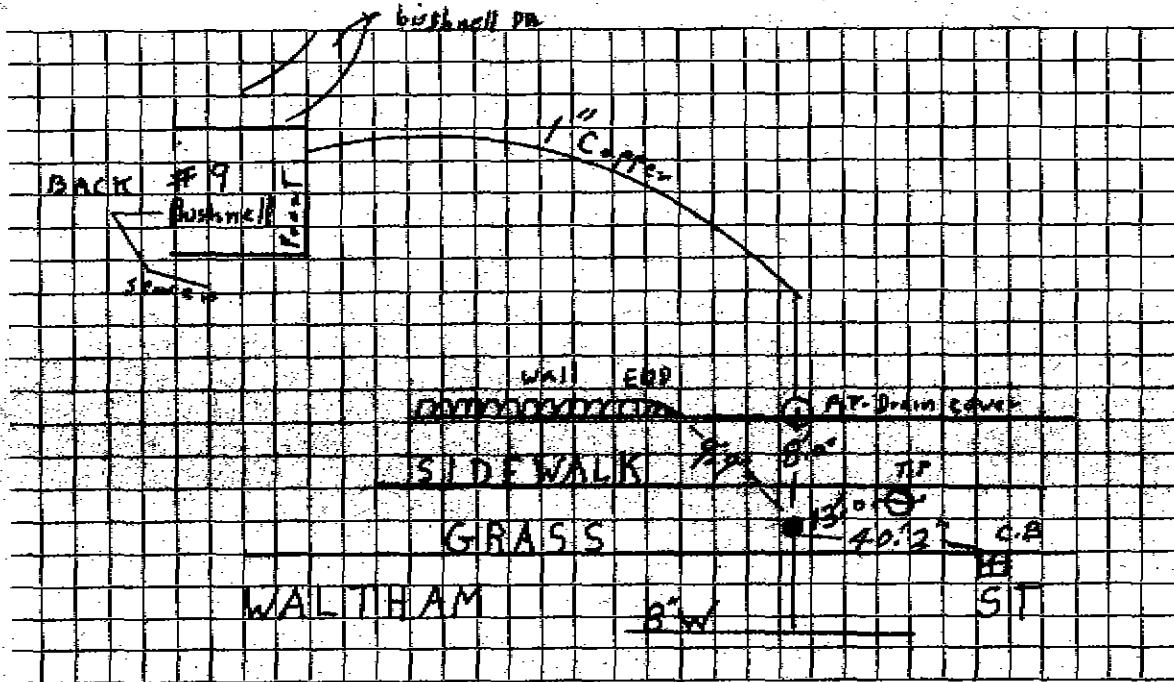

Connection made in WALTHAM ST Street. Work completed J. McLaughlin

Remarks: M. & T. moved inside house  
(Was 217 Waltham St.)