

WATER SERVICE RECORD

Name

Service No.

Address 15 Butler Avenue

Location


~~Repair~~—Renewal—~~New Service~~ W.O. #3261

Date		Material	Amount	Total	Date	Amount
9-15-66		Labor	31 89			
		10% O.H.	3 19	35 08		
	20'	3/4" copper tubing @ .79		15 80		
	1	3/4" Curb Cock		8 76		
	1	1" Coupling		2 81		
	1	3/4" Adapter		2 76		
	2	Hrs. Trucking @ 3.00		6 00		
	2	Hrs. Tractor @ 6.50		13 00		
				<u>84 21</u>		
		<u>CURB TO MAIN</u>				

DATE _____

TOWN OF LEXINGTON — BOARD OF PUBLIC WORKS
WATER DIVISION

Sketch of Service Here

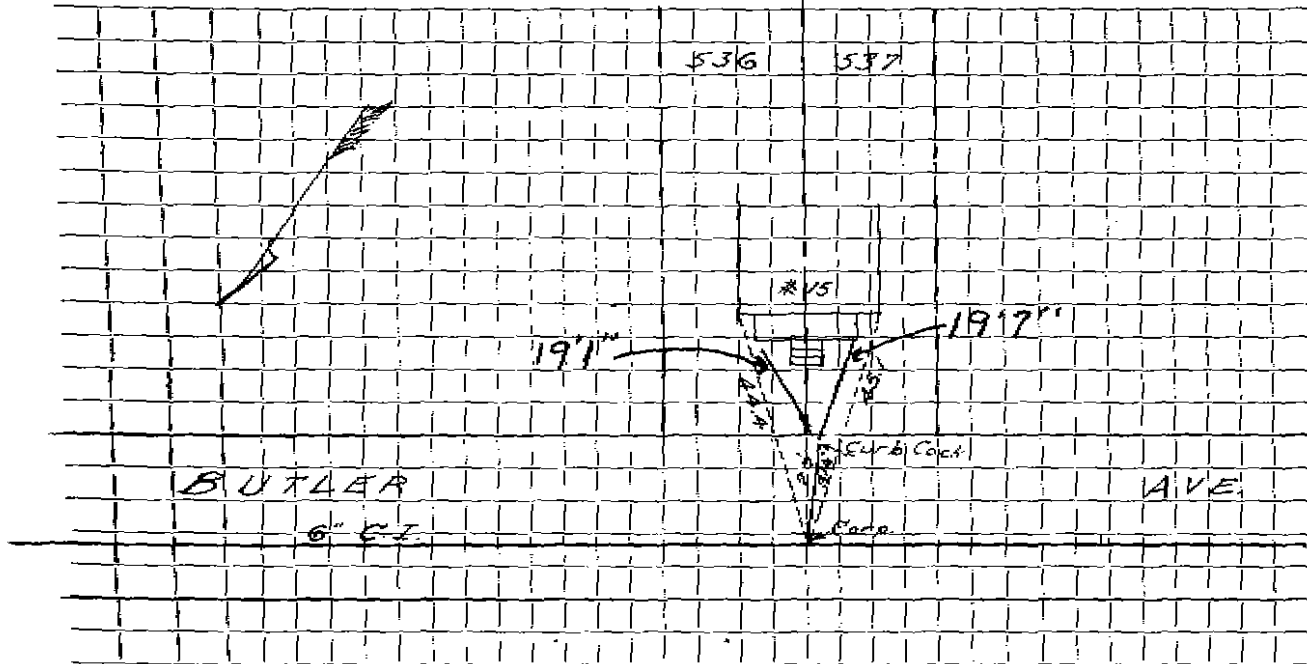

Connection made in Street. Work completed

Remarks:
.....
.....