

WATER SERVICE RECORD

Name Wesley Nelson

Service No. 14

Address 19 Butler Avenue

Location

~~Repair - Renewal~~ - New Service Lexington Landscaping #227 Permit - W.O.#9621


OCT 25 1965

Date	Material	Amount	Total	Date	Amount
4-6-65	Labor	4 97		3-25-65	50 00
	10% O.H.	50	5 47	10-25-65	15 06
20'	3/4" Copper tubing @.42		8 40		34 94
1	3/4" Corp. Cock		7 41		
1	3/4" Curb Cock		8 76		
1	Box & Rod		4 90		
			34 94		
4-22-65	41' 3/4" copper tubing				

DATE _____

TOWN OF LEXINGTON — BOARD OF PUBLIC WORKS
WATER DIVISION

Sketch of Service Here

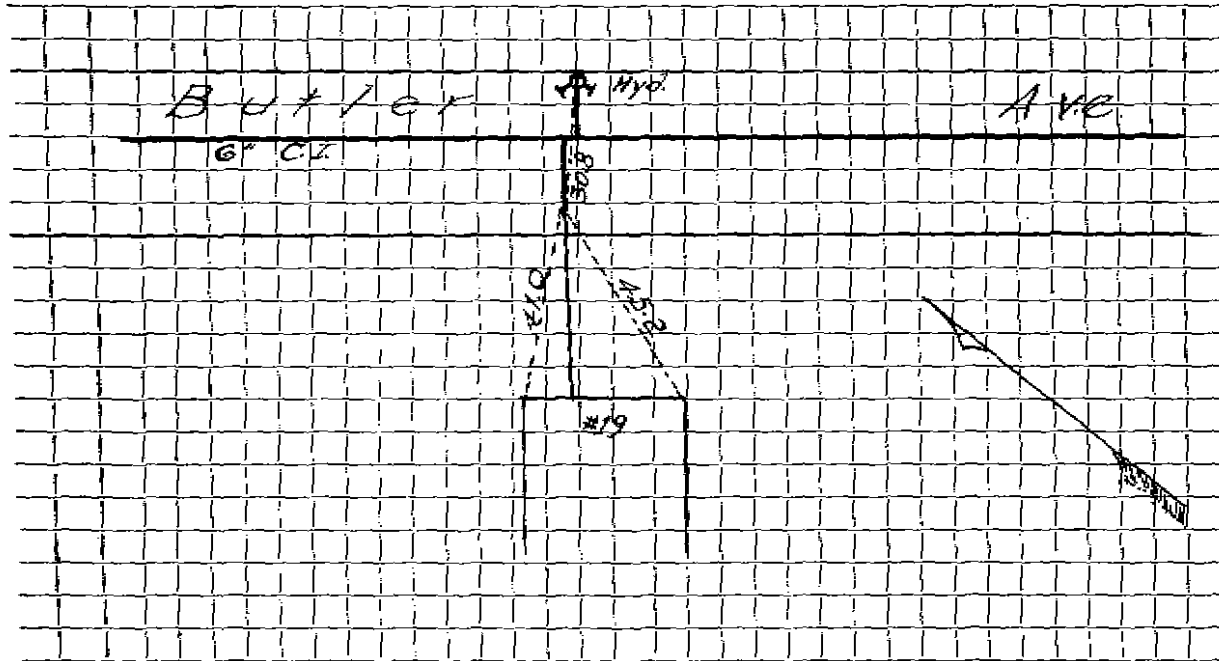

Connection made in _____ Street. Work completed _____

Remarks: _____

