


DATE _____

TOWN OF LEXINGTON — BOARD OF PUBLIC WORKS

WATER DIVISION

Sketch of Service Here

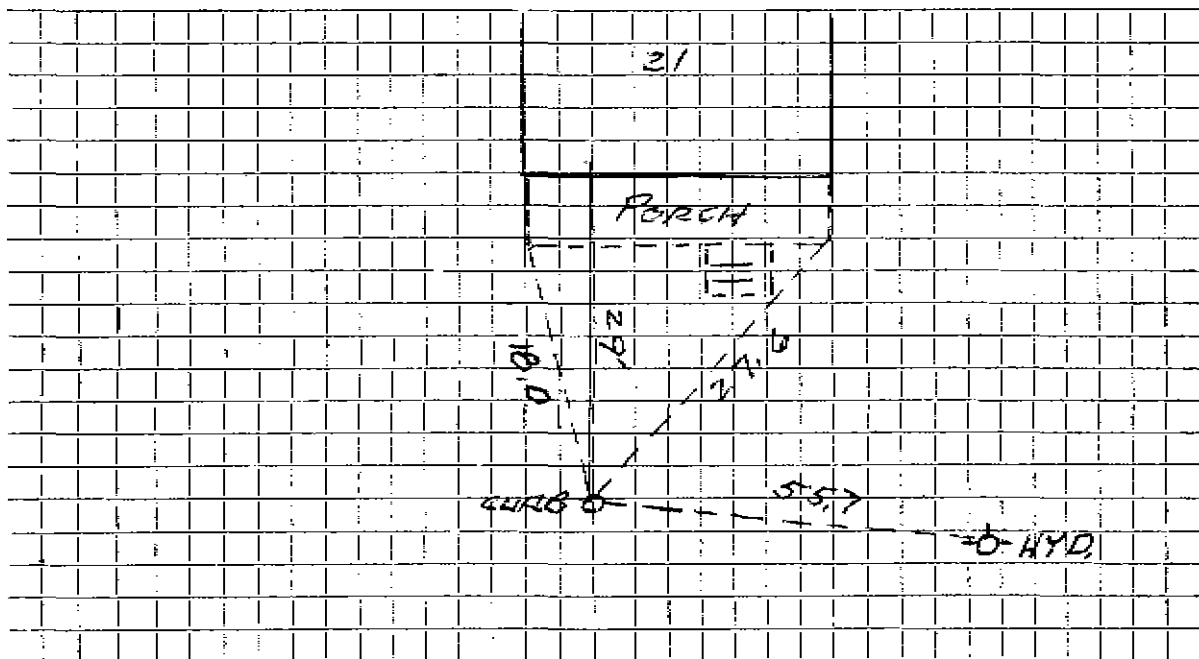

Connection made in BUTLER AVE, Street. Work completed

Remarks: NEW CURB BOX

.....

.....