


DATE _____

TOWN OF LEXINGTON — BOARD OF PUBLIC WORKS
WATER DIVISION

Sketch of Service Here

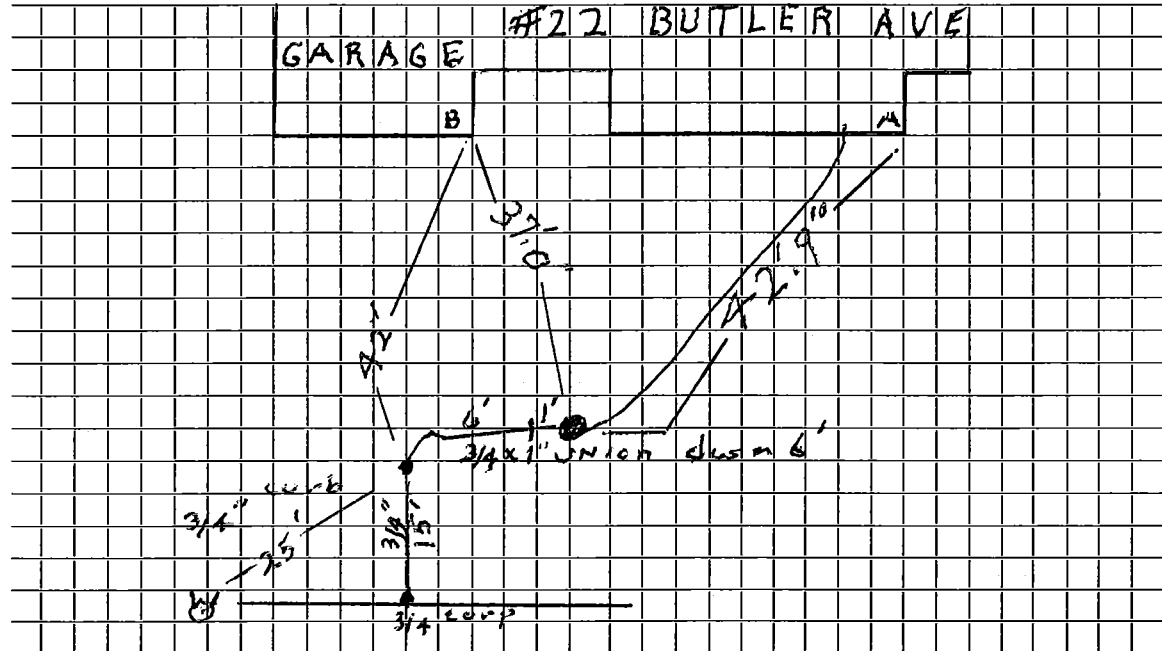

Connection made in Street. Work completed Feb 2012 Redmond

Remarks: Old Curb left in place

.....
.....