

WATER SERVICE RECORD

Name Wesley Nelson

Service No. 15

Address 23 Butler Avenue

Location

~~Repair/ Renewal~~ New Service Lexington Landscape Permit #228 - W.O.#9622

OCT 25 1965


Date	Material	Amount	Total	Date	Amount
4-6-65	Labor	4 73		3-25-65	50 00
	10% O.H.	47	5 20	10-28-65	12 39
27'	3/4" Copper tubing @.42		11 34		37 41
1	3/4" Corp. Cock		7 41		
1	3/4" Curb Cock		8 76		
1	Box & Rc		4 90		
			37 61		
4-16-65	35' 3/4" copper tubing				

DATE _____

TOWN OF LEXINGTON — BOARD OF PUBLIC WORKS

WATER DIVISION

Sketch of Service Here

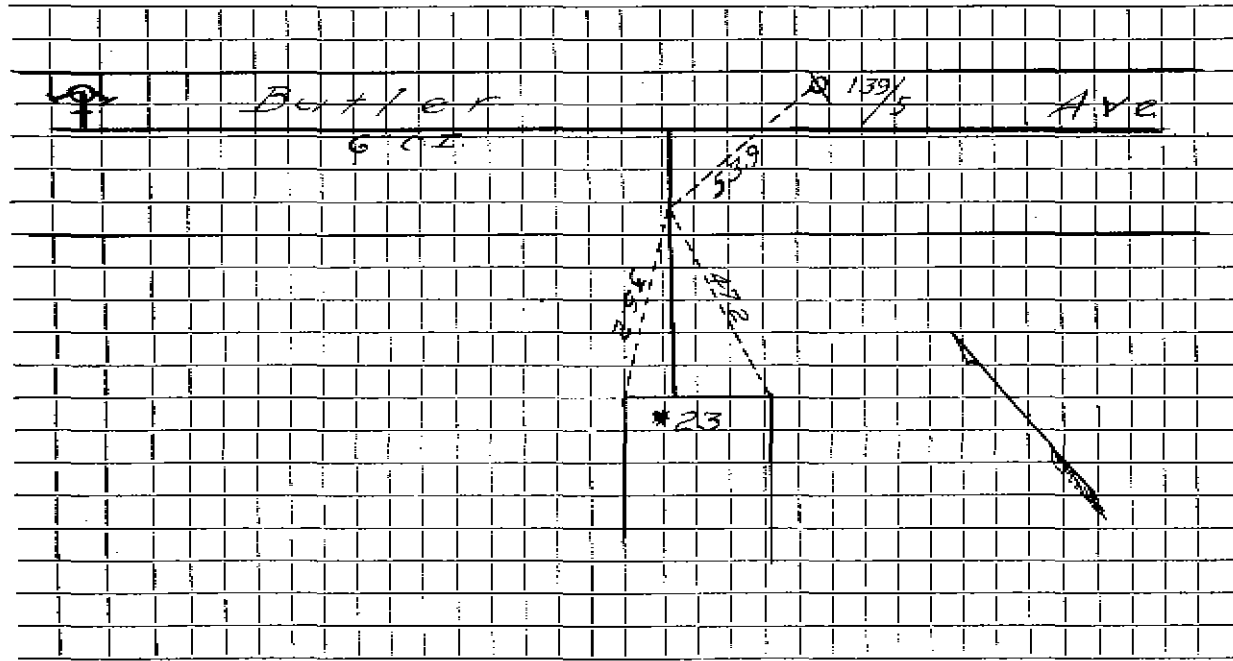

Connection made in Street. Work completed

Remarks:
.....
.....