

WATER SERVICE RECORD

Name

Service No.

Address 24 Butler Avenue (Vacant lot)

Location

~~REPLACEMENT~~ New Service W.O #2876


Date	Material	Amount	Total	Date	Amount
8-2-66/8-3-66	Labor	50 80			
	10% O.H.	<u>5 08</u>	55 88		
12'	3/4" copper tubing @ .79		9 48		
1	3/4" Corp. Cock		7 42		
1	3/4" Curb Cock		8 76		
1	Box & Rod		5 10		
1hr	Trucking		3 00		
1hr	Shovel		6 50		
			<u>96 14</u>		
	(TO BE BILLED WHEN CONNECTED)				

DATE _____

TOWN OF LEXINGTON — BOARD OF PUBLIC WORKS

WATER DIVISION

Sketch of Service Here

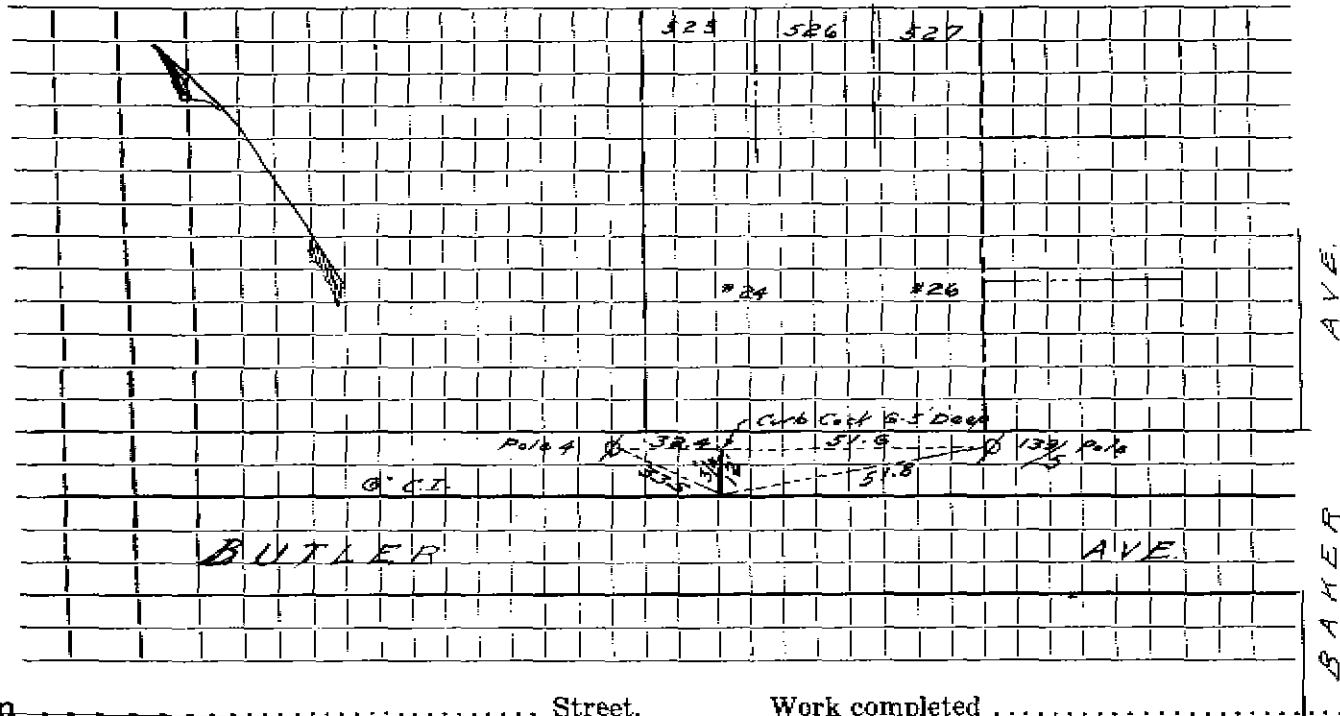

Connection made in _____ Street. Work completed _____

Remarks: _____
