

**WATER SERVICE RECORD**

Name: Margaret Wright

**Address** 26 Butler Avenue

#### Location

**Rental—Renewal—New Service W.O. #326**

**Service No.**


~~#~~ 216

**DATE:** \_\_\_\_\_

**TOWN OF LEXINGTON — BOARD OF PUBLIC WORKS**

**WATER DIVISION**

### **Sketch of Service Here**

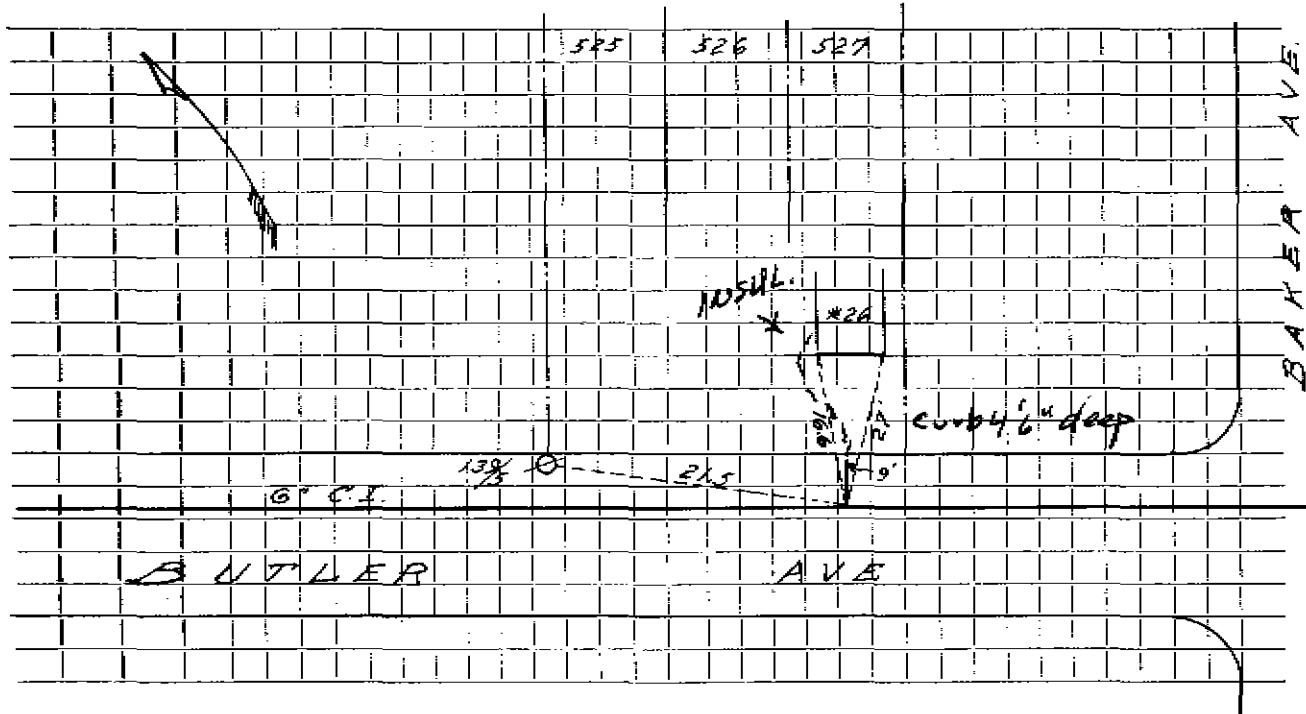

**Connection made in** ..... **Street.** ..... **Work completed** .....

**Remarks:** \_\_\_\_\_