

WATER SERVICE RECORD

Name Richard Tracey

Service No. 149

Address 5 Butler Avenue

Location

Repair—Renewal—~~New Service~~

*Com. 8-15-55*


Date	Material	Amount	Total	Date	Amount
6/16/55	Labor	24 87		5-26-55 Deposited	50 00
	10% Overhead	2 49	27 36	8-15-55 Refunded	3 30
	38' - 3/4" copper tubing @ .3840	14 59		<u>NON CHARGE</u>	
	1 - 3/4" C x 1/2" I.W.H. stop & waste	4 00		6/16/55 Labor	28 50
	1 hr. trucking		75	20' - 3/4" copper tubing @ .3840	7 68
			46 70	1 - 3/4" C. Adapter	1 95
				1 - 3/4" x 3/4" curb cock	4 67
				1 box and rod	3 90
				1 - 1/2" straight tail piece	50
				1 - 1/2" offset tail piece	50
				2 hr. town shovel @ 5.00	10 00
				1 hr. trucking	75
					58 45

DATE \_\_\_\_\_

TOWN OF LEXINGTON — BOARD OF PUBLIC WORKS

**WATER DIVISION**

Sketch of Service Here

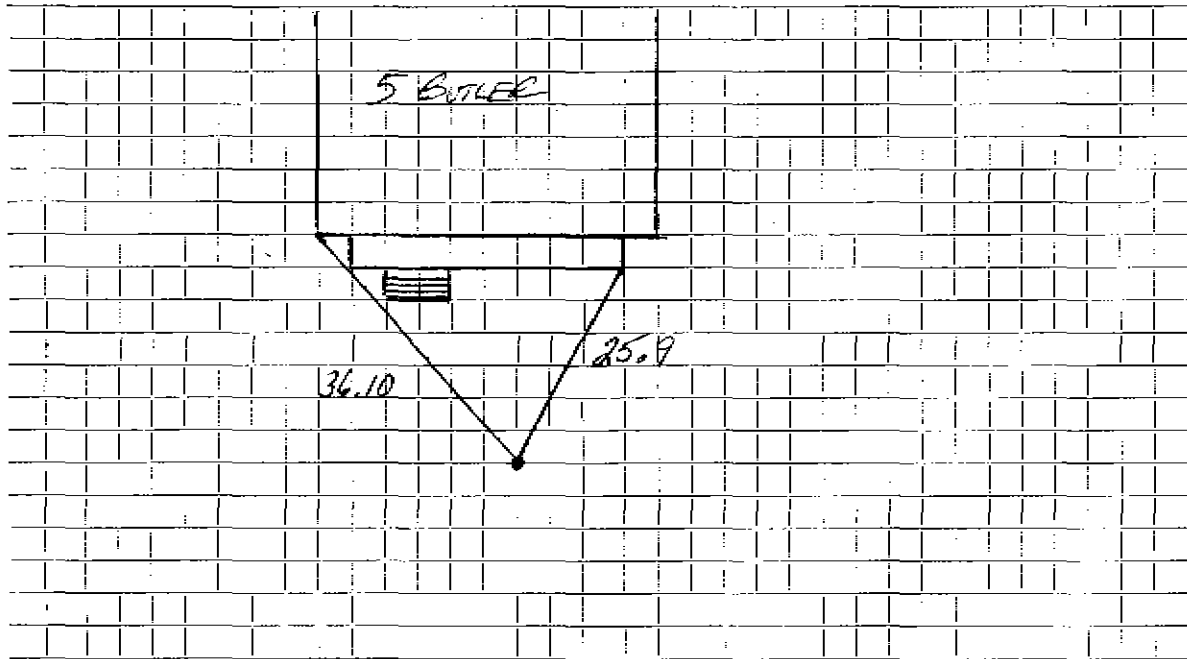

Connection made in ..... Street. Work completed .....

Remarks: .....

.....

.....