

WATER SERVICE RECORD

Name *David Kidd*

Service No.

Address *7 Butler Avenue*

Location

~~Repair~~—Renewal—~~NEW SERVICE~~ W.O. #3259


Date	Material	Amount	Total	Date	Amount
	<u>MAIN TO CURB</u>				
9-16-66	Labor	33 52			
	10% O.H.	3 35	36 87		
20'	3/4" copper tubing @ .79		15 80		
1	1" Repair Clamp		2 25		
1	3/4" Curb Cock		8 76		
1	3/4" Adapter		2 76		
8	Hrs. Trucking @ 3.00		6 00		
2	Hrs. Shovel @ 6.50		13 00		
			85 14		
	<i>Repair By Arlex #3860</i>				
12/1/83	53 1/2' 3/4" Copper				
	3/4 x 3/4 Wheel Valve				
60'	Insulation				

DATE _____

TOWN OF LEXINGTON — BOARD OF PUBLIC WORKS

WATER DIVISION

Sketch of Service Here

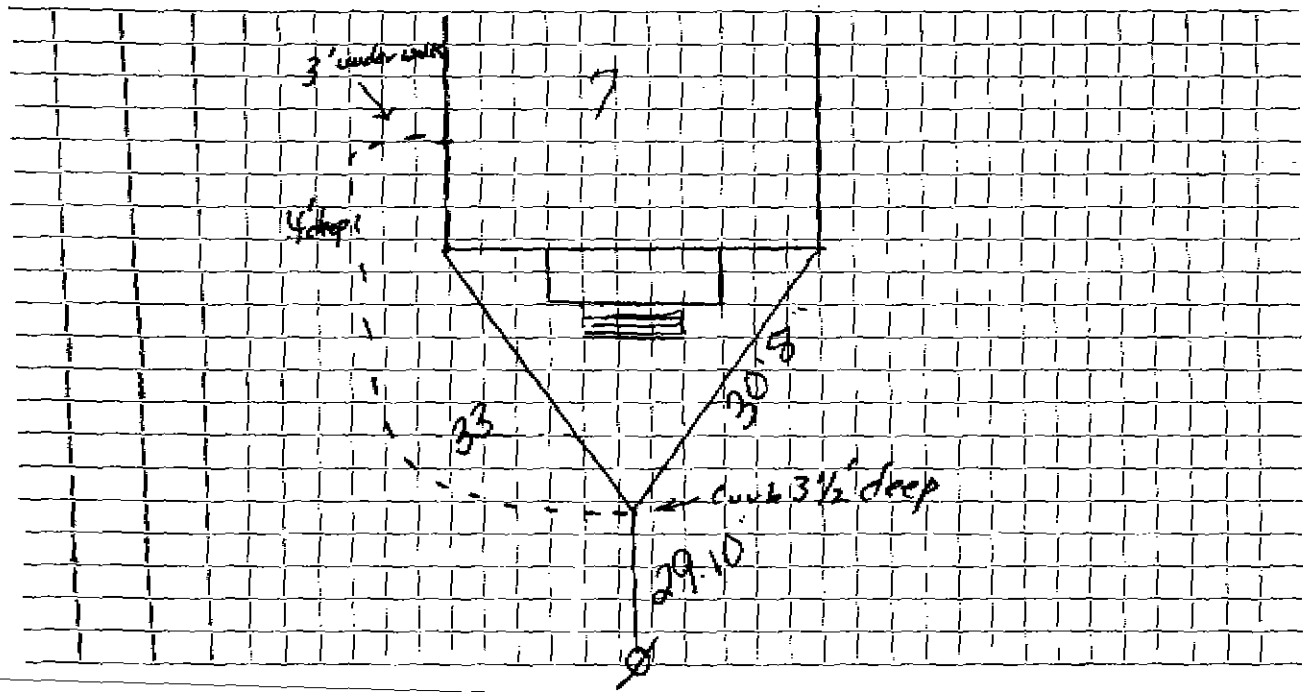

Connection made in Street. Work completed

Remarks: Service insulated from curb to house

.....
.....