

WATER SERVICE RECORD

Name Oscar Carlson

Service No. 78

Address 8 Butler Avenue

Location W.O.#9052 Permit #56

~~Repair Renewal~~ New Service David Eagle-92 Applewood Dr., Marlboro, Mass.


DEC 28 1964

Date	Material	Amount	Total	Date	Amount
8-13-64	Labor	10 58		7-31-64	25 00
	10% O.H.	1 06	11 64	12-28-64	13 59
	14' 3/4" Copper tubing @.42		5 88		38 59
	1 3/4" Corp Cock		7 41		
	1 3/4" Curb Cock		8 76		
	1 Box & Rod		4 90		
			38 59		
8-17-64	35' 3/4" Copper Tubing				

DATE _____

TOWN OF LEXINGTON — BOARD OF PUBLIC WORKS
WATER DIVISION

Sketch of Service Here

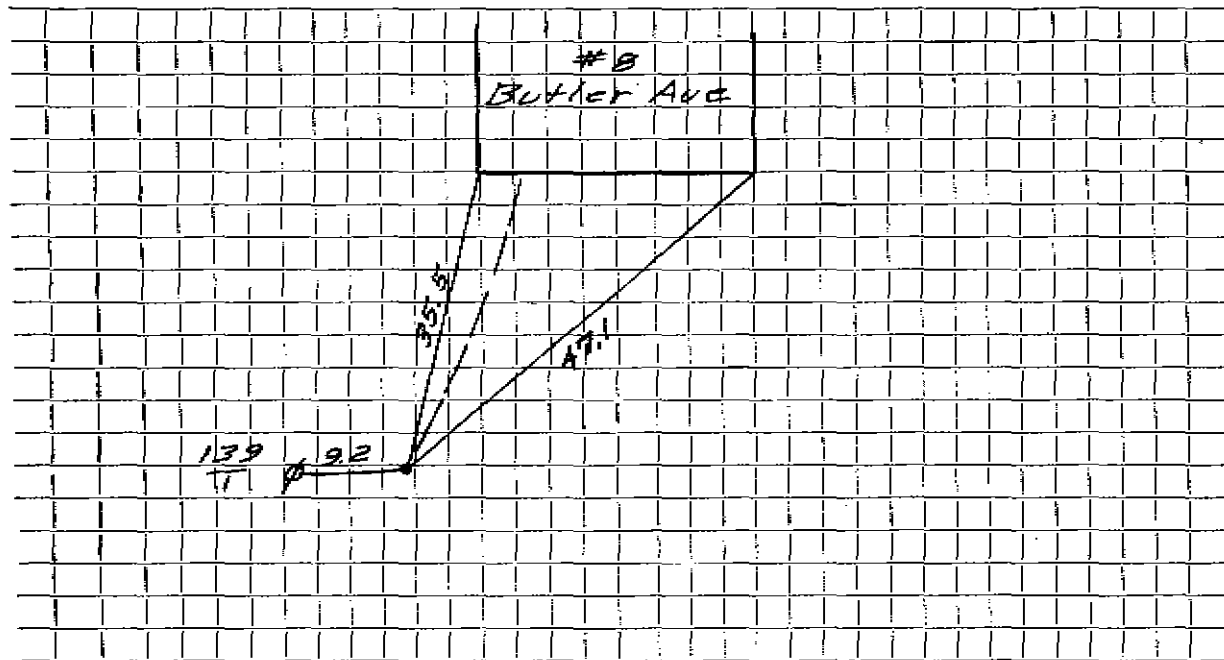

Connection made in Street. Work completed

Remarks:
.....
.....