


DATE _____

TOWN OF LEXINGTON — BOARD OF PUBLIC WORKS

WATER DIVISION

Sketch of Service Here
#12 LOT 2

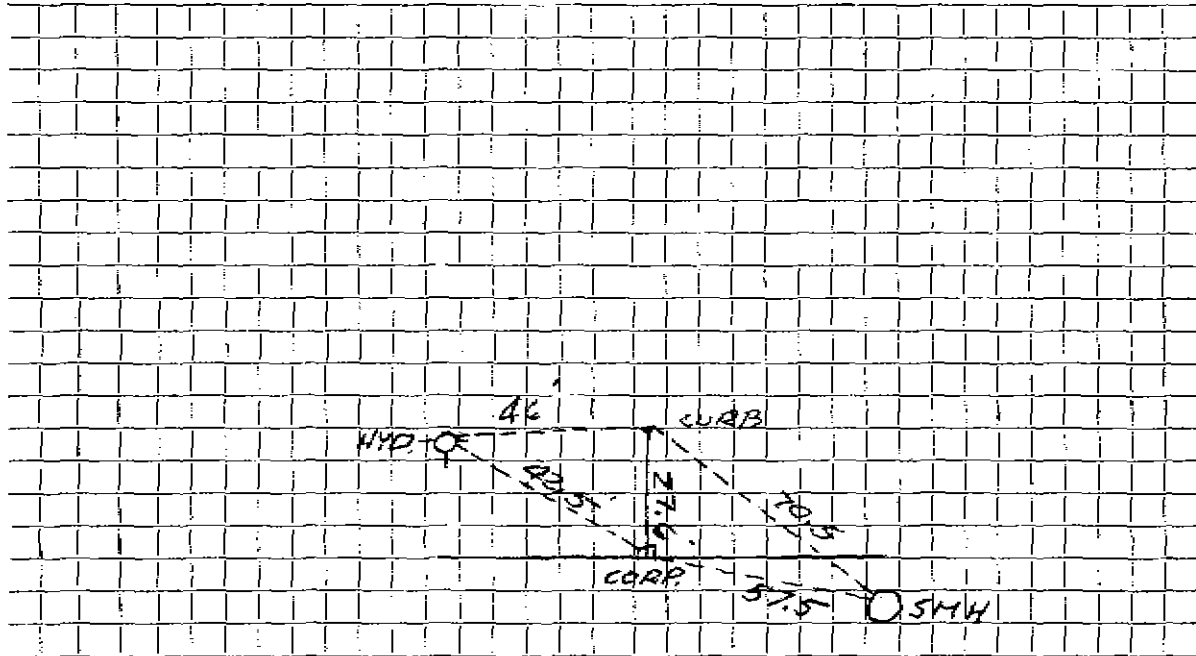

Connection made in BUTTERFIELD ROAD Street. Work completed

Remarks:

.....

.....