


TOWN OF LEXINGTON — BOARD OF PUBLIC WORKS

WATER DIVISION

DATE _____

Sketch of Service Here

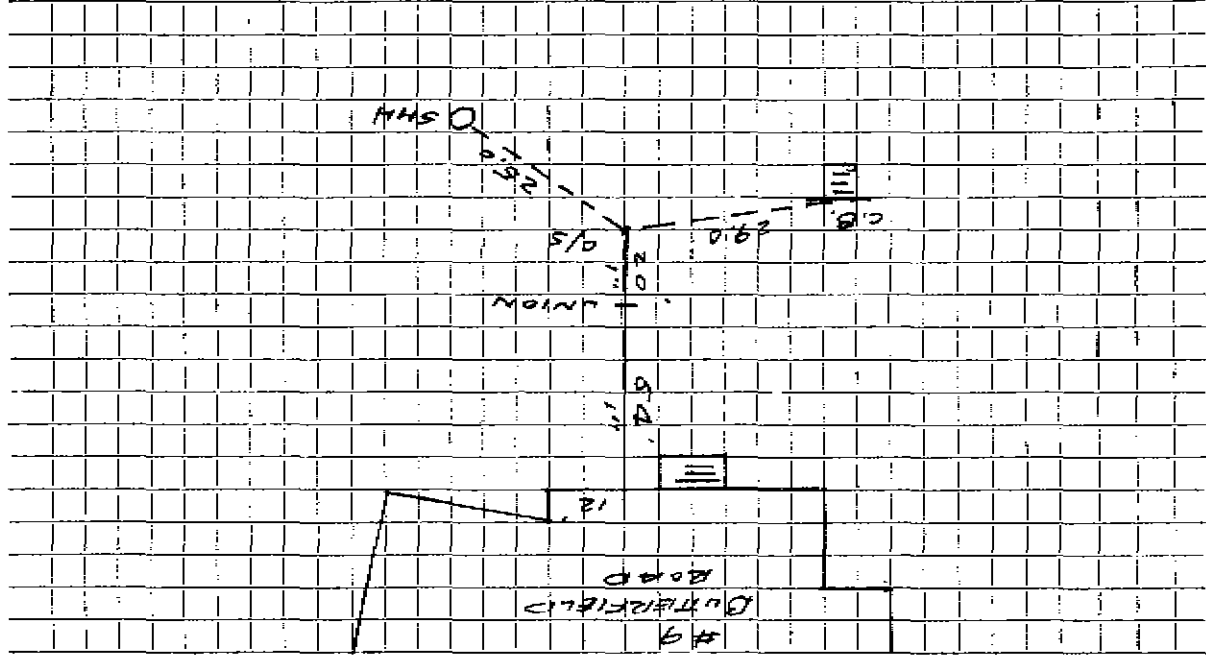

Street. Work completed

BUTTERFIELD ROAD

Connection made in

Remarks: