




DATE \_\_\_\_\_

TOWN OF LEXINGTON — BOARD OF PUBLIC WORKS

**WATER DIVISION**

Sketch of Service Here

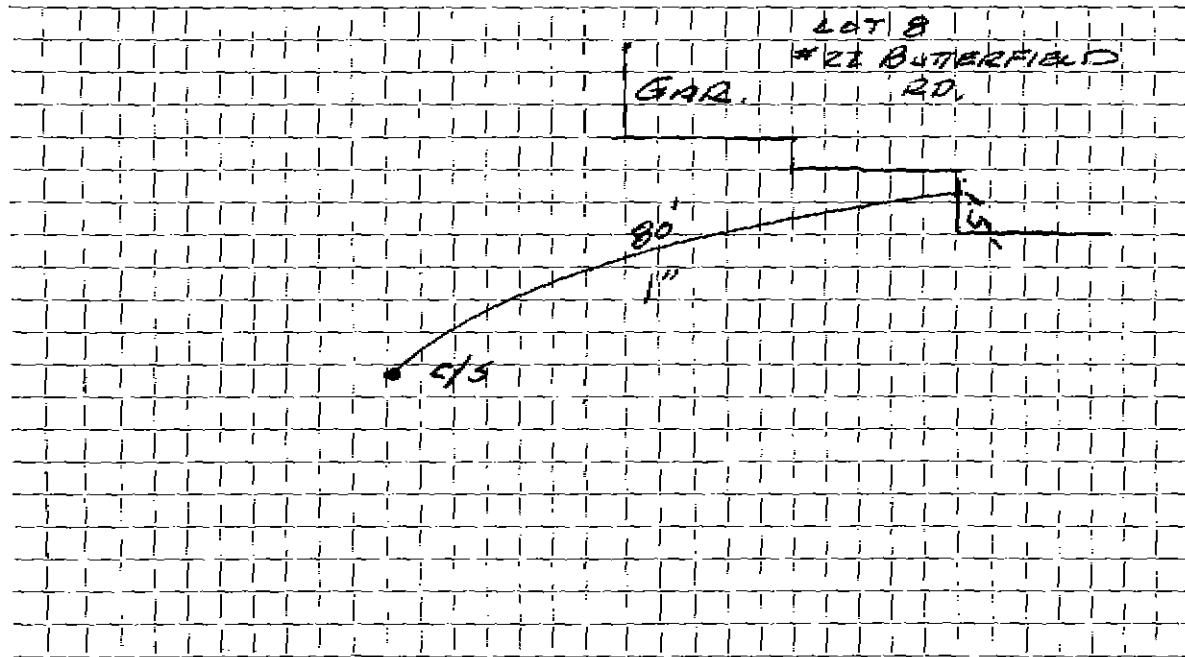

Connection made in BUTTERFIELD RD. Street. Work completed .....

Remarks: .....  
.....  
.....