




DATE \_\_\_\_\_

TOWN OF LEXINGTON — BOARD OF PUBLIC WORKS  
WATER DIVISION

Sketch of Service Here

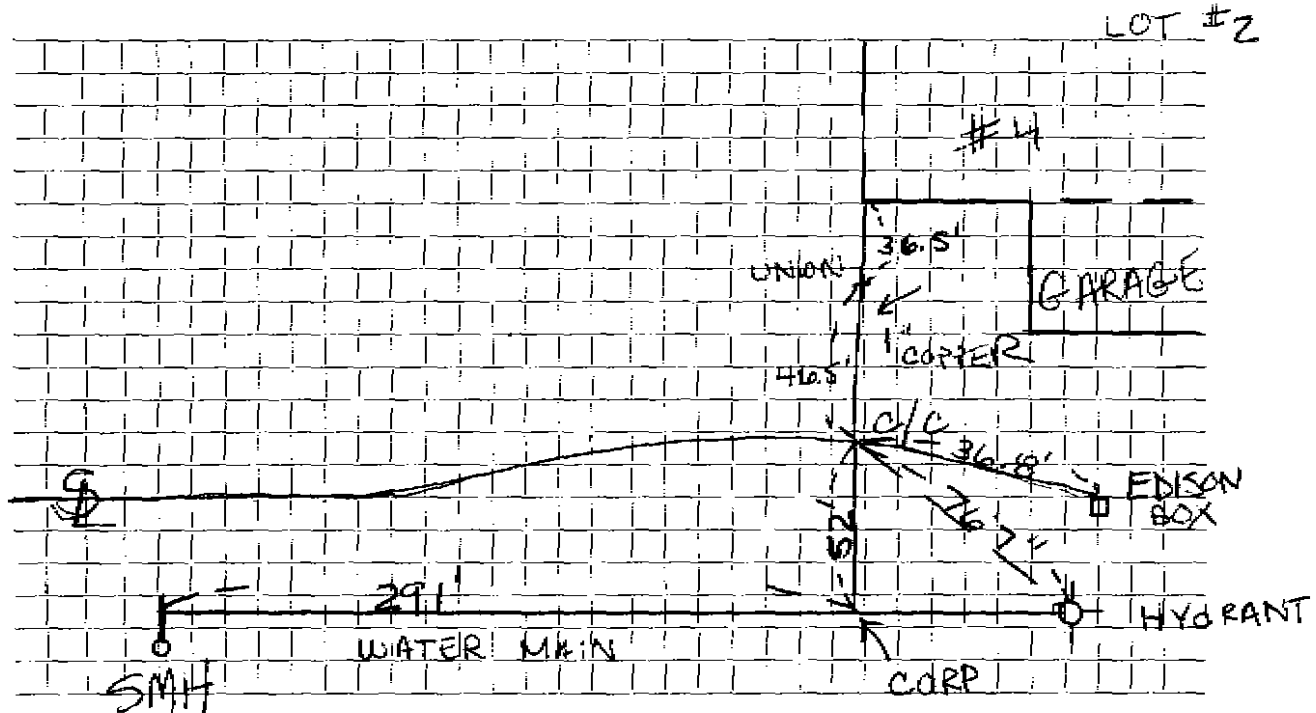

Connection made in MAPLE TREE LANE Street. Work completed .....

Remarks: .....

.....

.....