



\*


DATE \_\_\_\_\_

TOWN OF LEXINGTON — BOARD OF PUBLIC WORKS

WATER DIVISION

LOT # 49

Sketch of Service Here

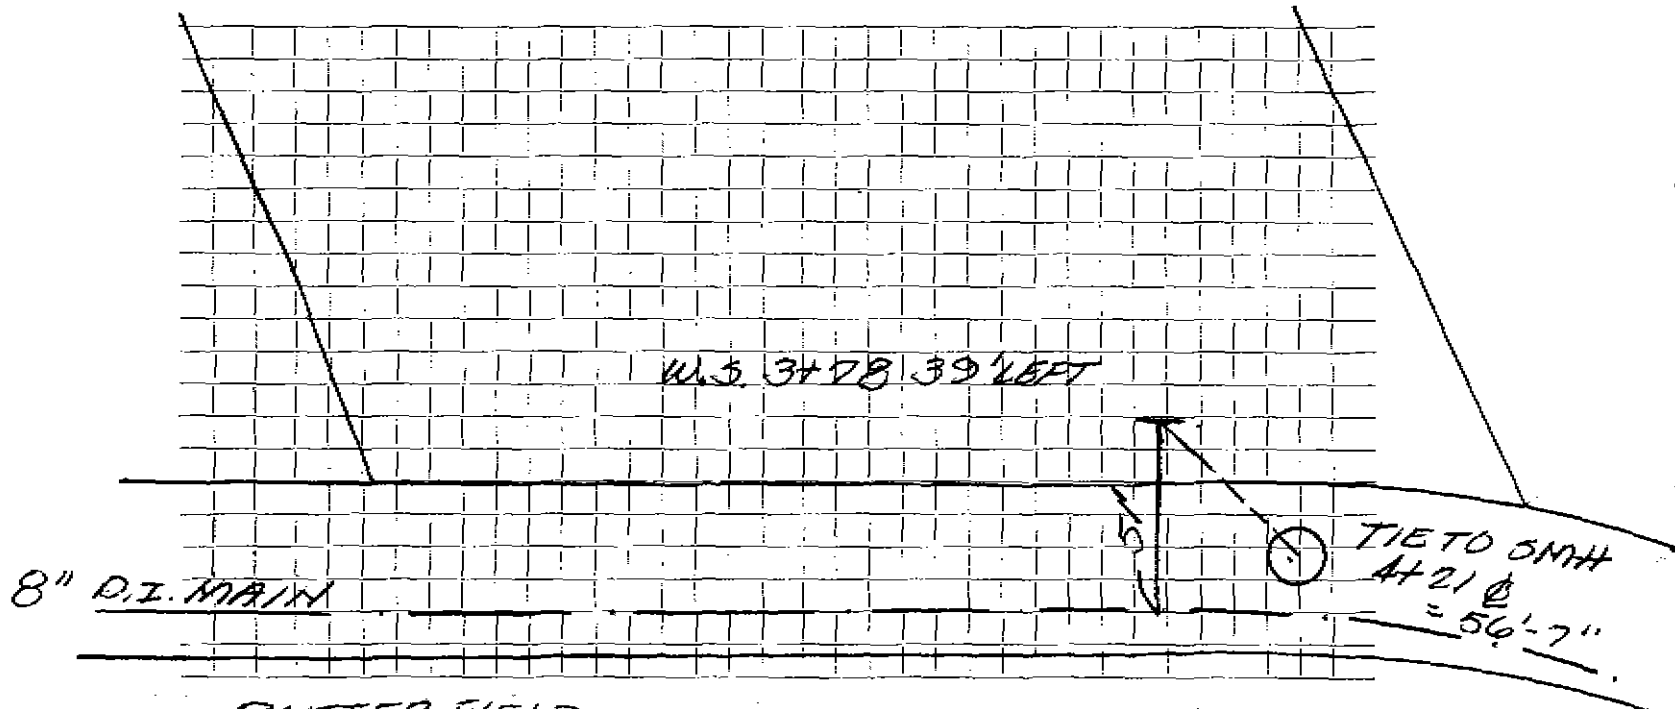

Connection made in BUTTER FIELD Street. Work completed .....

Remarks: .....  
.....  
.....




DATE \_\_\_\_\_

TOWN OF LEXINGTON — BOARD OF PUBLIC WORKS

WATER DIVISION

Sketch of Service Here

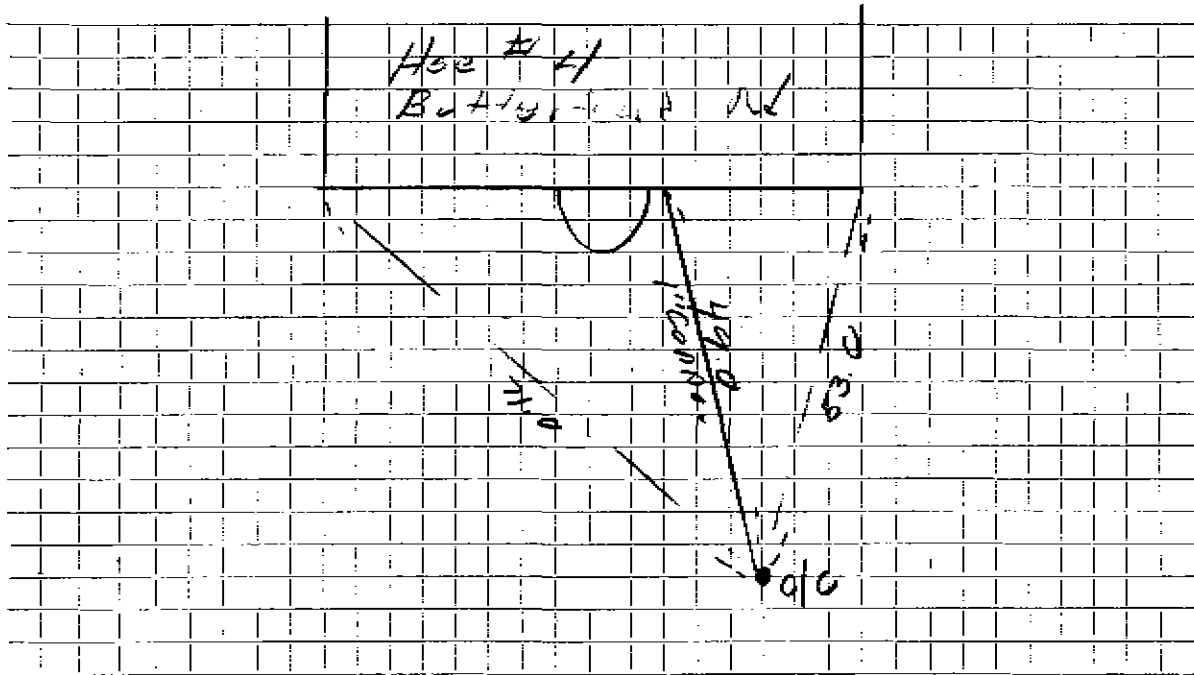

Connection made in Butterfield Rd Street Work completed 1986

Remarks: .....

.....

.....