


DATE 6/20/96

TOWN OF LEXINGTON — BOARD OF PUBLIC WORKS

WATER DIVISION

Sketch of Service Here

7 BUTTERFIELD RD

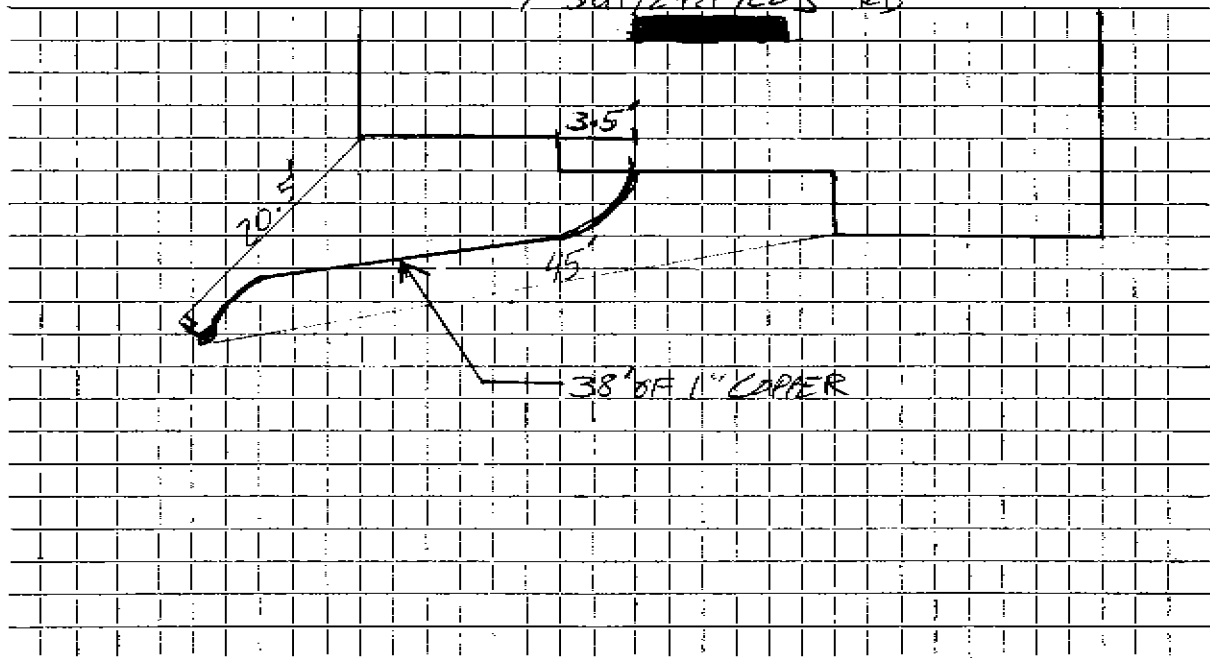

Connection made in Street. Work completed


Remarks:
.....
.....

TOWN OF LEXINGTON — BOARD OF PUBLIC WORKS

WATER DIVISION

LOT # 32

Sketch of Service Here

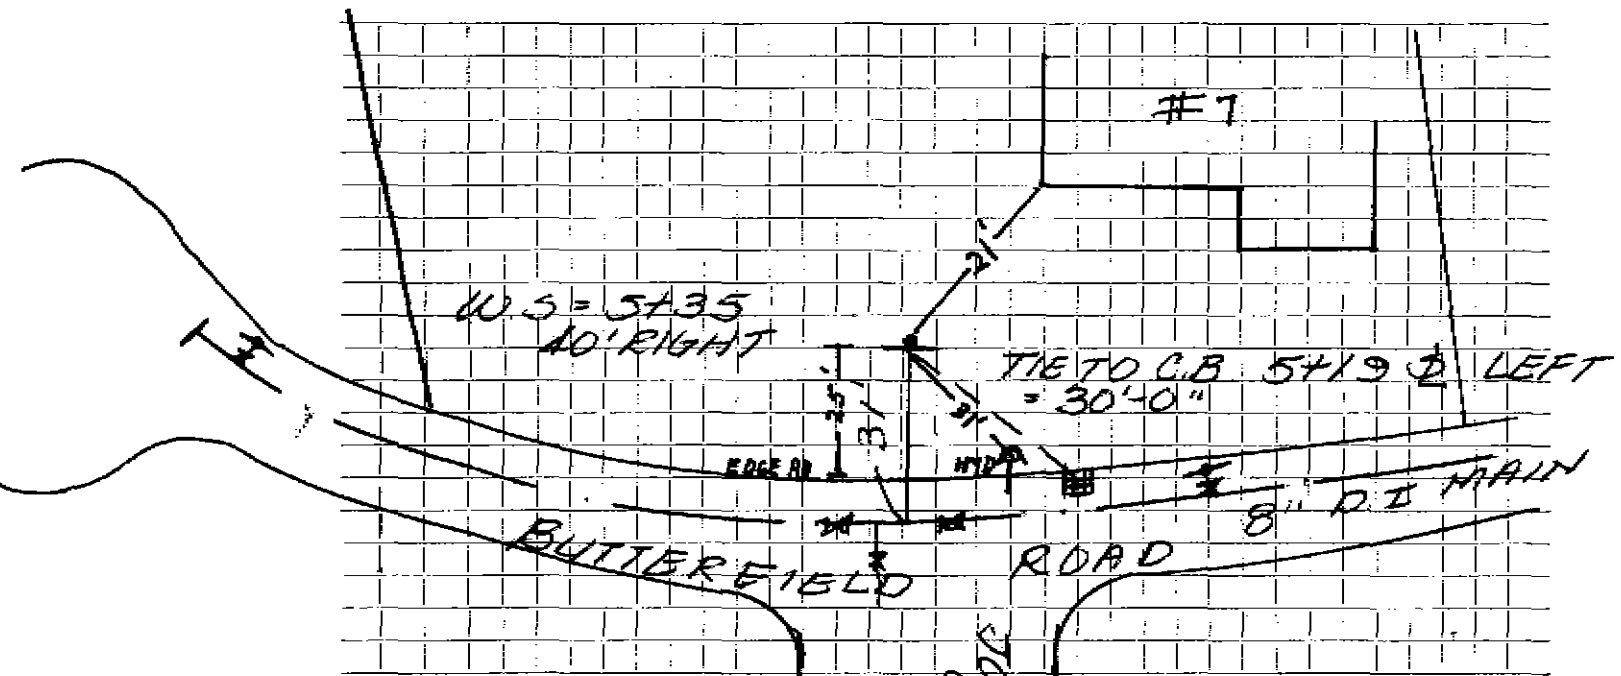

Connection made in BUTTERFIELD Street. JOSEPH COMBE Work completed

Remarks:

.....

.....