


TOWN OF LEXINGTON — BOARD OF PUBLIC WORKS

WATER DIVISION

LOT # 34

JOSEPH COMES

Sketch of Service Here

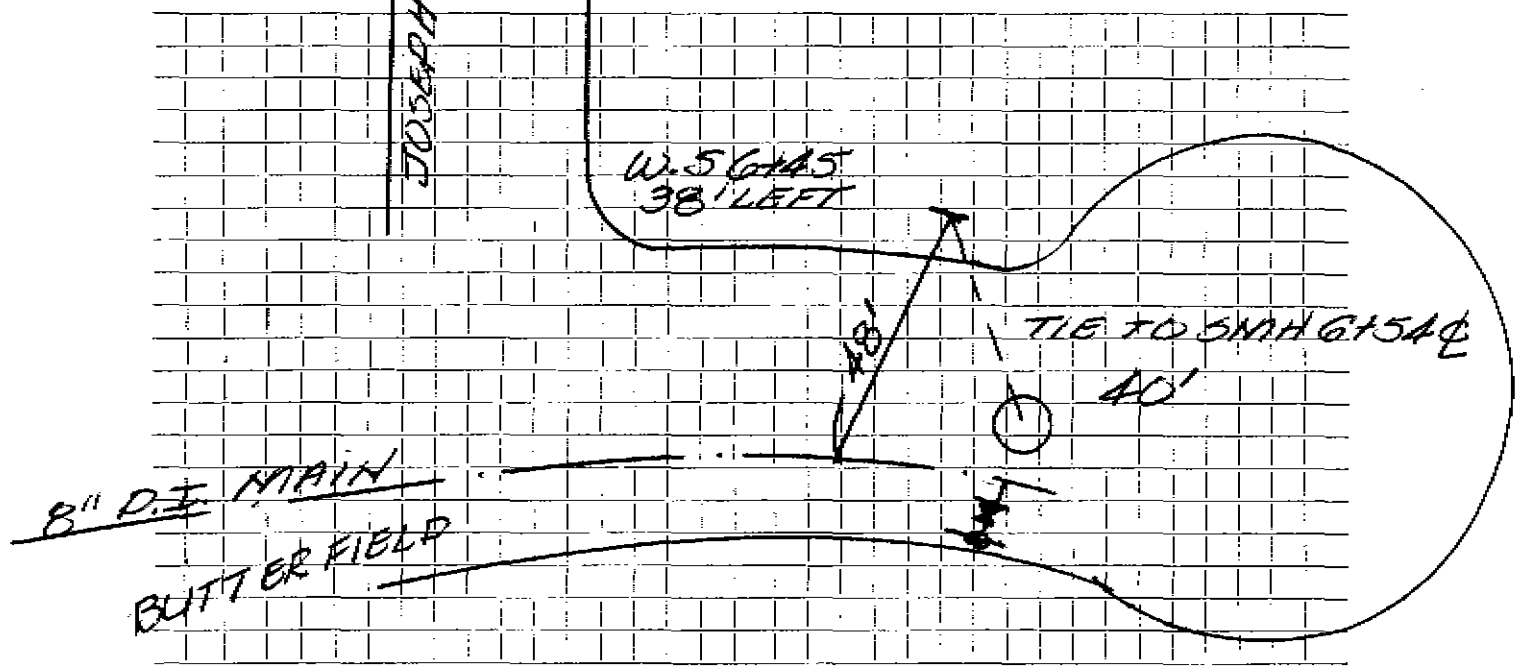

Connection made in BUTTERFIELD Street. Work completed

Remarks:
.....
.....