




DATE \_\_\_\_\_

TOWN OF LEXINGTON — BOARD OF PUBLIC WORKS

WATER DIVISION

Sketch of Service Here

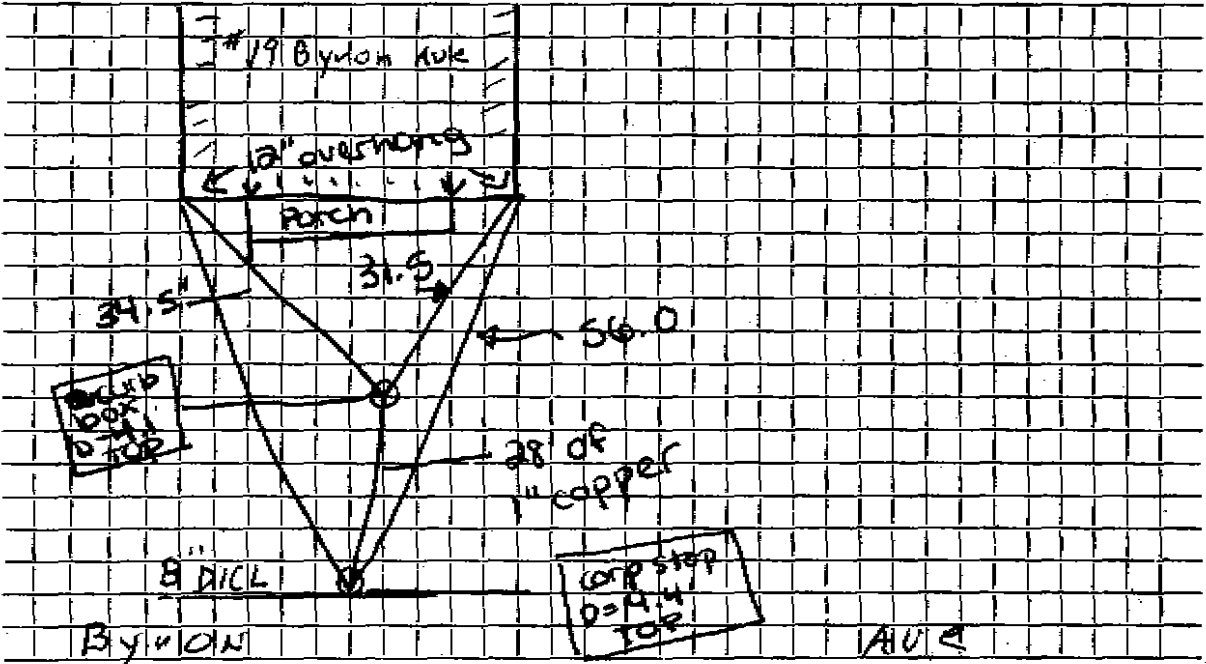

Connection made in \_\_\_\_\_ Street. Work completed 5/29/07 Deflice

Remarks: \_\_\_\_\_  
 \_\_\_\_\_  
 \_\_\_\_\_