

Name Arthur Mitchell
 Address 11 Calvin Street
 Lexington, Mass.

Service No. 67

Location 11 Calvin Street

Kind of Pipe

Size

Size of Main

~~Repair - Renewal - New Service~~

Com. 5-29-50

Location

Date	Material	Amount	Total	Date	Location	Amount
May 6, '50	Labor	2 45	2 45	April 24, '50	Deposited	30 00
	10% Overhead		25	June 8 '50	Refunded	8 44
	34' - 3/4" Copper Tubing @.23		7 82		No Charge	21 56
	1 - 3/4" C x 1/2" I.W.H. S&W		3 29	May 6, '50	Labor	2 45
	Littlefield Shovel 1 hr. @ 7.00	7 00	7 00		15' - 3/4" Copper Tubing @.23	3 45
	Trucking 1 hr. @.75		75		1 - 3/4" C Corp-cock	3 15
			21 56		1 - 3/4" C x 3/4" C Curb-cock	3 85
					1 - Box & Rod	3 60
					1 - 1/2" Offset Tail Piece	38
					1 - 1/2" Straight Tail Piece	38
					Littlefield Shovel 1 hr. @ 7.00	7 00
					Trucking 1 hr. @.75	75
	Labor					25 01

DATE _____

TOWN OF LEXINGTON - BOARD OF PUBLIC WORKS
WATER DIVISION

The undersigned applies for a supply of water at No..... St. and hereby agrees to comply with the rules and regulations as now, or at any future time, established by the Board of Selectmen.

Am't of Estimate \$.....

Owner


Am't Paid \$.....

Address

Builder

.....

Sketch of Service Here

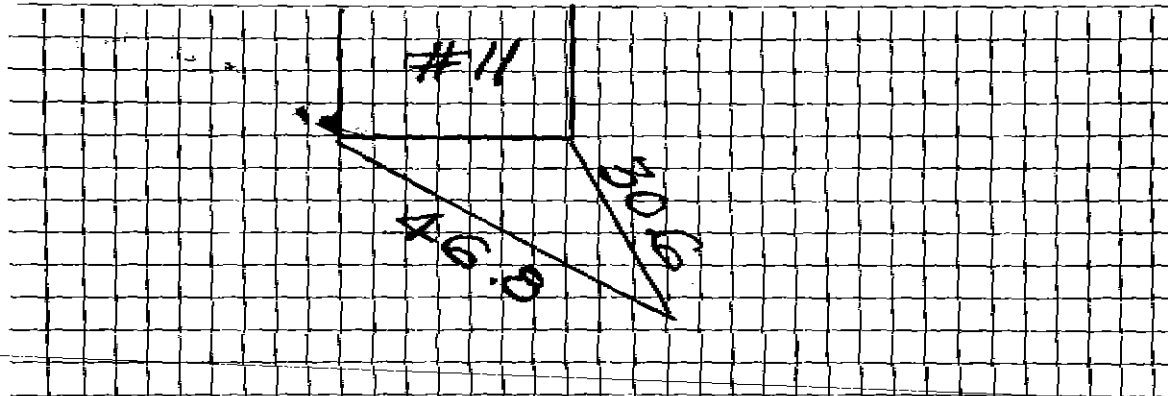

Connection made in Street.

Work completed19

Remarks: