

Name Arthur Mitchell

Service No. 104

4867

Address 15 Calvin Street

Lexington

Location 15 Calvin Street

Kind of Pipe

Size

Size of Main

~~Repair - Renewal~~ New Service

Com. 7-3-50

Location

Date	Material	Amount	Total	Date	Location	Amount
May 31 '50	Labor		1 30	May 23 '50	Deposited	35 00
	10% Overhead		13	July 20 '50	Refunded	5 89
	38' - 3/4" Copper Tubing @ 23¢		8 74			28 21
	1 - 3/4"C x 1/2" I.W.H. S&W		3 29		<u>No Charge</u>	
	2 hrs. Littlefield Shovel		14 00	May 31 '50	Labor	1 30
	1 hr. Trucking		75	12' 3/4" Copper Tubing @ 23¢		2 76
			28 21	1 - 3/4"C. Corp-cock		3 15
				1 - 3/4"C x 3/4"C Curb-cock		3 85
				1 Box and Rod		3 35
				1 - 1/2" Straight Tail Piece		38
				1 - 1/2" Offset Tail Piece		38
				1 hr. Littlefield Shovel		7 00
				1 hr. Trucking		75
	Labor					22 92

Hudley Press, Inc., Lexington

DATE _____

TOWN OF LEXINGTON—BOARD OF PUBLIC WORKS

WATER DIVISION

The undersigned applies for a supply of water at No. _____ St. and hereby agrees to comply with the rules and regulations as now, or at any future time, established by the Board of Selectmen.

Am't. of Estimate \$ _____


Owner _____

Am't. Paid \$ _____

Address _____

Builder _____

Sketch of Service Here

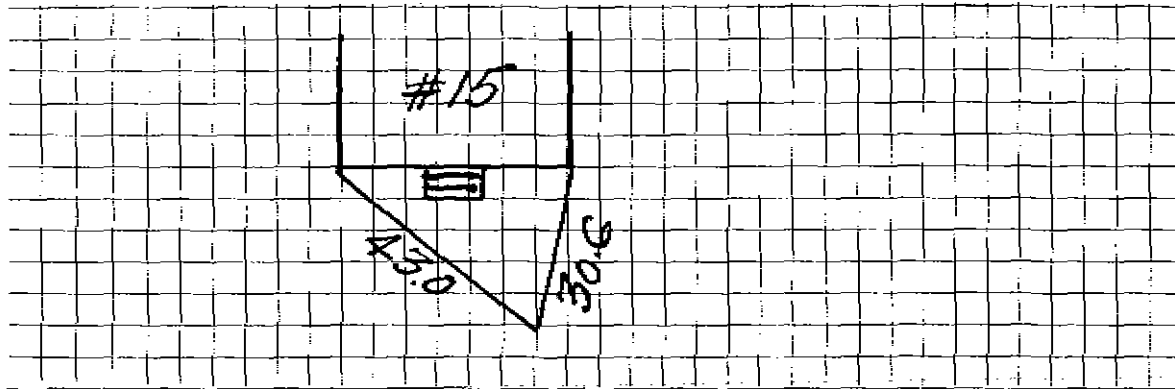

Connection made in _____ Street.

Work completed _____ 19

Remarks: