

Name Arthur Mitchell
 Address 16 Calvin Street
 Lexington, Mass.

Service No. 208

5889

Location 16 Calvin Street

Kind of Pipe

Size

Size of Main

~~Repair - Renewal~~ New Service

Com. 11-6-50

Location

Date	Material	Amount	Total	Date	Amount
Aug. 28, '50	Labor	2 55	2 55	Aug 28 '50	35 00
	10% Overhead		26	Aug 29 '50	4 25
	36' - 3/4" Copper Tubing @.275		9 90		30 75
	1 - 3/4" C x 1/2" I.W.H. S&W		3 29	Aug. 28, '50 Labor	3 00
	Littlefield Shovel 2 hrs. @7.00		14 00	23' - 3/4" Copper Tubing @.275	6 33
	Trucking 1 hr. @.75		75	1 - 3/4" C Corp-cock	3 15
			30 75	1 - 3/4" C x 3/4" C Gurb-cock	3 85
				1 - Box @ Rod	3 35
				1 - 1/2" Offset Tail Piece	42
				1 - 1/2" Straight Tail Piece	42
				Littlefield Shovel 2 hrs. @7.00	14 00
				Trucking 1 hr. @.75	75
	Labor				<u>35 27</u>

Reported
11-6-50
 No Charge

Hadley Press, Inc., Lexington

DATE _____

TOWN OF LEXINGTON—BOARD OF PUBLIC WORKS

WATER DIVISION

The undersigned applies for a supply of water at No. _____ St. and hereby agrees to comply with the rules and regulations as now, or at any future time, established by the Board of Selectmen.

Am't. of Estimate \$ _____


Owner _____

Am't. Paid \$ _____

Address _____

Builder _____

Sketch of Service Here

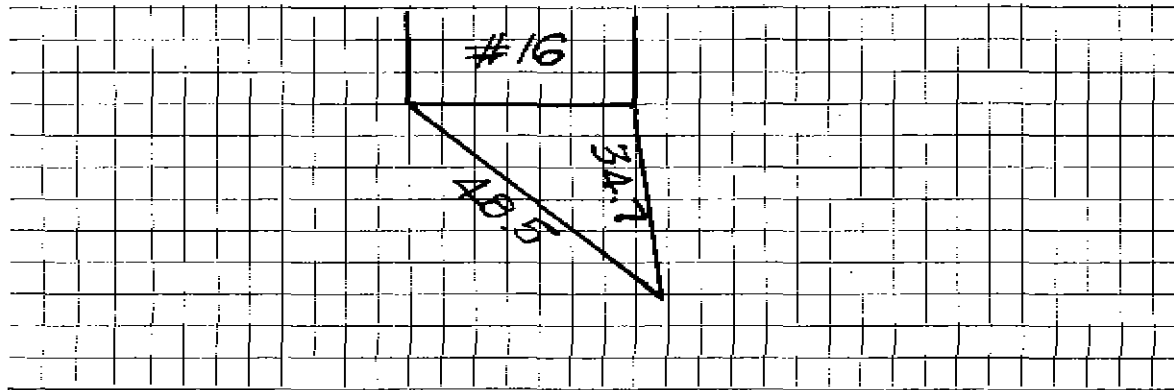

Connection made in _____ Street.

Work completed _____ 19

Remarks: