




DATE 2/1/17

TOWN OF LEXINGTON — BOARD OF PUBLIC WORKS

WATER DIVISION

Sketch of Service Here

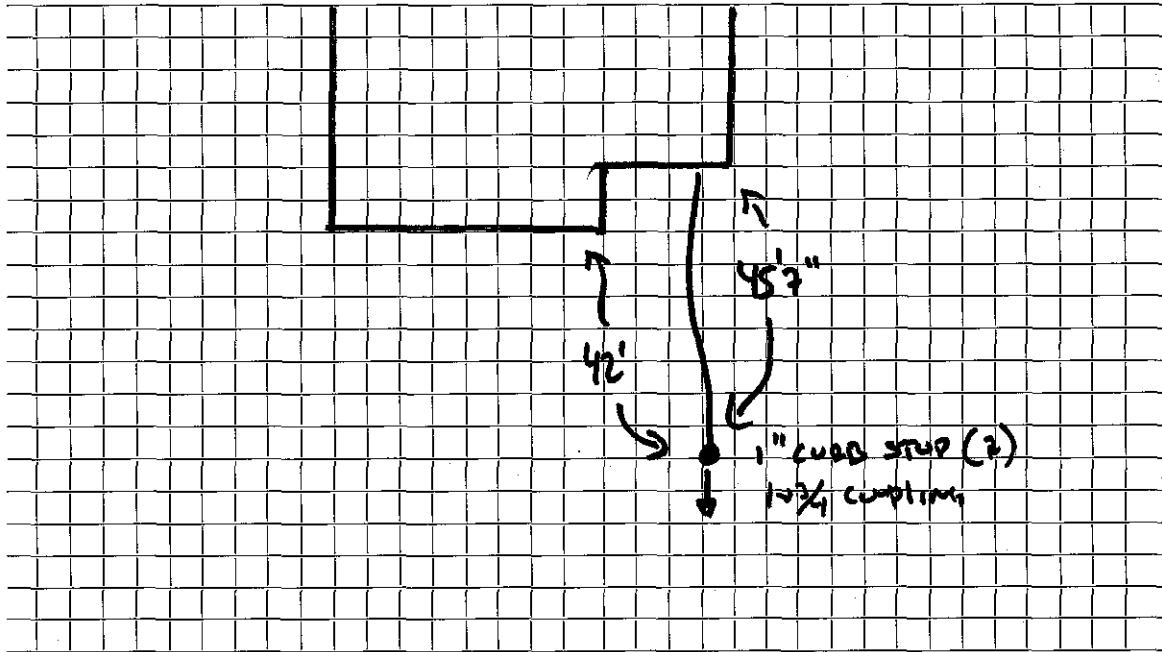

Connection made in CALVIN Street.

Work completed BRADLEY CO.

Remarks: Added 2 1/4" CURB