

WATER SERVICE RECORD

Service No. 269

Name Charles H. Murray

Address 21 Calvin St.

Location

~~Repair/Repair~~ - New Service


Comm 11-9-53

Date	Material	Amount	Total	Date	Amount
9/18/53	Labor	1 75		9-9-53 Deposited	20 00
	10% Overhead	18	1 93	11-9-53 Refunded	1 99
	45'-3/4" Copper tubing @ .3629	36 29	16 33	NON CHARGE	23 01
	1 - 3/4" C x 1/2" I.W.R. stop & waste	4 00		9/18/53 Labor	1 75
	1 hr. trucking		75	10' - 3/4" Copper tubing @ .3629	3 53
			23 01	1 - 3/4" C. corp-cock	4 33
				1 - 3/4" x 3/4" C. curb-cock	4 67
				1 box and rod	3 90
				1-1/2" straight tail piece	50
				10-1/2" offset tail piece	50
				1 hr. trucking	75
					20 03

DATE _____

TOWN OF LEXINGTON — BOARD OF PUBLIC WORKS
WATER DIVISION

Sketch of Service Here

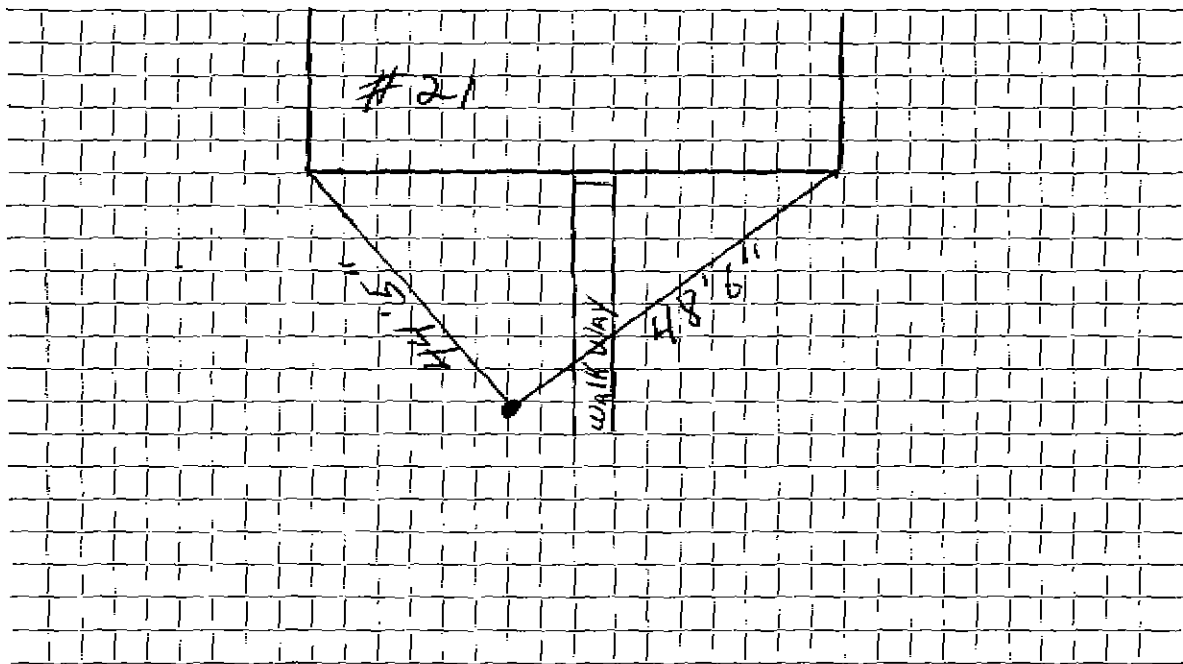

Connection made in Street. Work completed

Remarks:
.....
.....