

Name **Myles Beers** #8746 WATER SERVICE RECORD

Service No. 310 #5144

Address 22 Calvin Street

Location Lexington, Mass.


Remarks ~~Repair~~ - New Service Com. 12-26-50

Date	Material	Amount	Total	Date	Material	Amount
Oct. 13, '50	Labor	1 25		Oct. 13, '50	Labor	35 00
Oct. 14, '50	Labor	1 35	2 60	Oct. 14, '50	Labor	2 00
	10% Overhead		26		No Charge	32 00
	42' - 3/4" Copper Tubing @.31	13 02		Oct. 14, '50	Labor	7 40
	1 - 3/4" C x 1/2" I.W.H. S&W	3 76			21' - 3/4" Copper Tubing @.31	6 51
	1 - 3/4" C x 3/4" C Union (3pts)	1 61			1 - 3/4" C Corp-cock	3 60
	Littlefield Shovel 1 1/2 hrs. @ 7.00	10 50			1 - 3/4" C x 3/4" C Curb-cock	4 40
	Trucking 1 hr. @ .75		75		1 - Box & Rod	4 44
			32 50		1 - 1/2" Offset Tail Piece	42
					1 - 1/2" Straight Tail Piece	42
					Littlefield Shovel 1 1/2 hrs. @ 7.00	10 50
					Trucking 1 hr. @ .75	75
						<u>38 44</u>

DATE _____

TOWN OF LEXINGTON — BOARD OF PUBLIC WORKS
WATER DIVISION

Sketch of Service Here

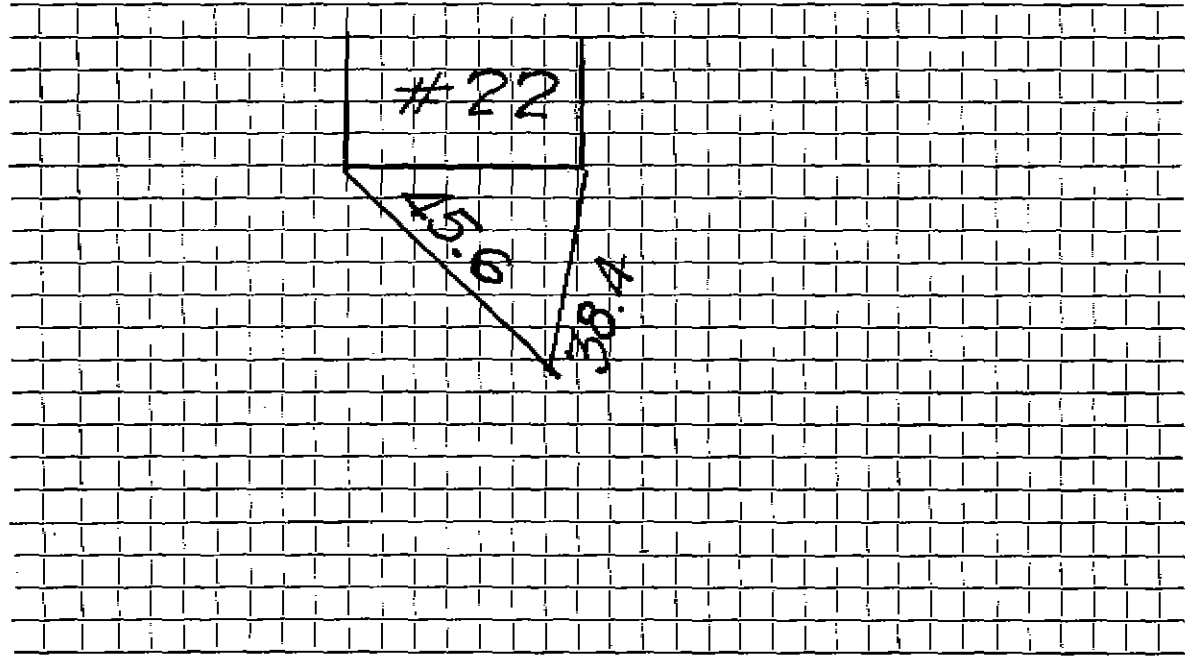

Connection made in Street. Work completed

Remarks:
.....
.....