

WATER SERVICE RECORD

Name Leo Ballou

Service No. 299 (1954)

Address 24 Calvin Street

2834

Location

~~Repair~~ ~~Extension~~ - New Service

Case 1-31-55


| Date | Material | Amount | Total | Date | Amount |
|--------|--------------------------------------|--------|-------|---------------------------------------------------------------------------------|-------------------------|
| 1/4/55 | Labor | 1 85 | | 11-24-54 | Deposited 25 00 |
| | 10% overhead | 19 | 2 04 | 1-31-55 | * Refunded (2 11 |
| | 46' - 3/4" copper tubing@.35 | | 16 10 | | <u>NON CHARGE</u> 22 89 |
| | 1 - 3/4" C x 1/2 I.W.H. stop & waste | | 4 00 | 1/4/55 | Labor 1 85 |
| | 1 hr. trucking | | 75 | 24' - 3/4" copper tubing@ .35 | 8 40 |
| | | | 22 89 | 1 - 3/4" C. corp-cock | 4 33 |
| | | | | 1 - 3/4" C. curb-cock | 4 67 |
| | | | | 1 box and rod | 3 90 |
| | | | | 1 - 1/2 straight tail piece | 50 |
| | | | | 1 - 1/2 offset tail piece | 50 |
| | | | | 1 hr. trucking | 75 |
| | | | | | 24 90 |
| | | | | * Refund made payable to Town to apply on bal. due on S.H.C. # 168 (1954) | |

DATE _____

TOWN OF LEXINGTON — BOARD OF PUBLIC WORKS

WATER DIVISION

Sketch of Service Here

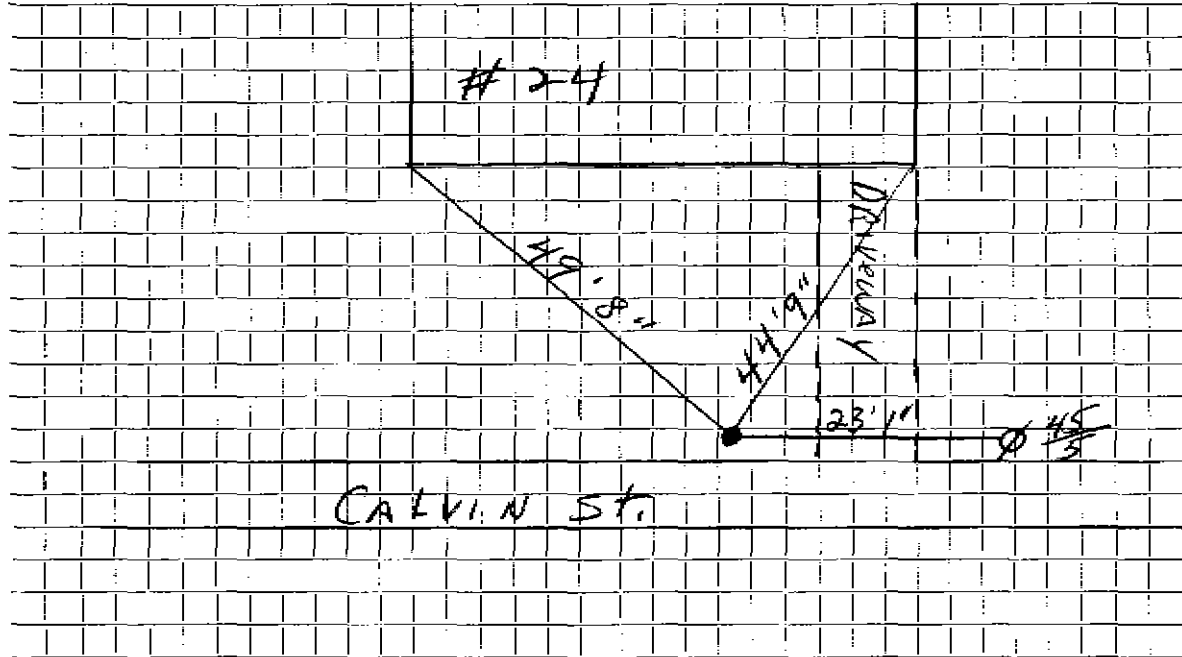

Connection made in Street. Work completed

Remarks:

.....

.....