

WATER SERVICE RECORD

Name William Sullivan

Service No. 315

Address 25 Calvin Street

# 2085

Location

~~Repair-Renewal~~ - New Service

*Com. 11-23-53*


Date	Material	Amount	Total	Date		Amount
10/8/53	Labor	1 75		10-1-53	<i>Deposited Refunded NON CHARGE</i>	25 00
	10% Overhead	18	1 93	11-23-53		13 80
	40' - 3/4" Copper tubing @ .3629	14 52				21 20
	1 - 3/4" Cx 1/2" I.W.H. stop & waste	4 00		10/8/53	Labor	1 75
	1 hr. trucking		75	14' - 3/4" Copper tubing @ .3629		5 08
			21 20	1 - 3/4" C. c orb-cock		4 33
				1 - 3/4" Cx 3/4" C. curb-cock		4 67
				1 box and rod		3 90
				1 - 1/2" offset tail piece		50
				1 - 1/2" straight tail piece		50
				1 hr. trucking		75
						21 48

DATE \_\_\_\_\_

TOWN OF LEXINGTON — BOARD OF PUBLIC WORKS

**WATER DIVISION**

Sketch of Service Here

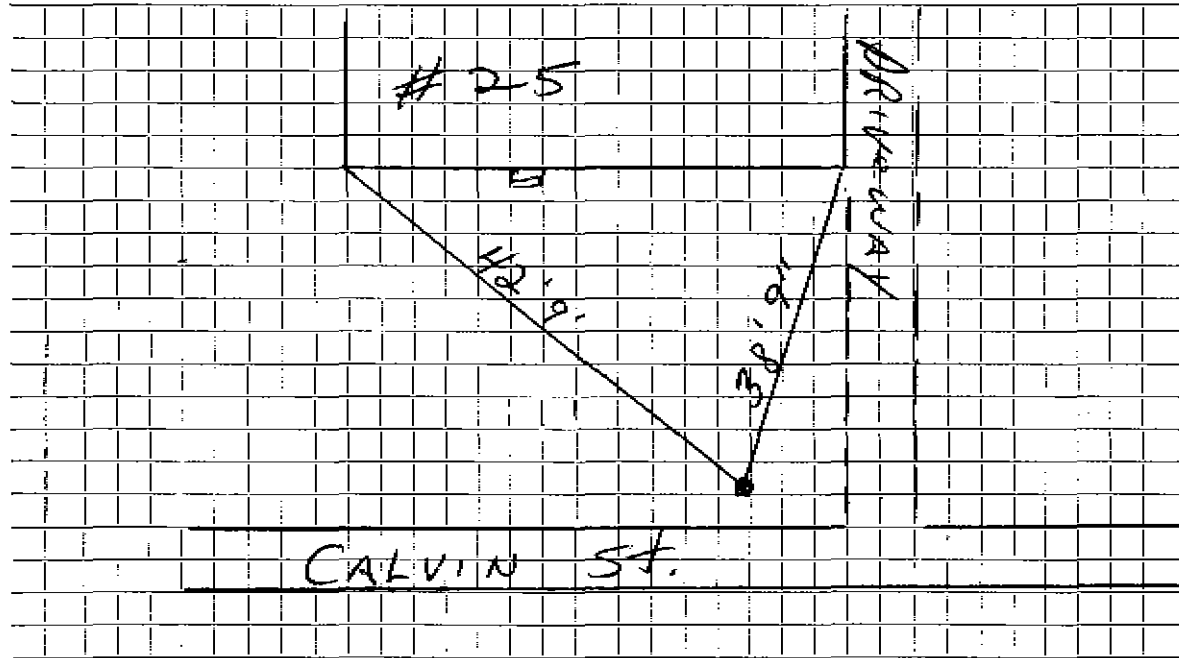

Connection made in ..... Street. Work completed .....

Remarks: .....

.....

.....