

WATER SERVICE RECORD

Name Rose DiFranco

Service No. 401

Address 28 Calvin Street # 3716

Location


~~Repair - General~~ New Service COM. 12-31-53

Date	Material	Amount	Total	Date	Amount
12/31/53	Labor	1 75		12-22-53	Deposited 25 00
	10% overhead	18	1 93	12-31-53	Refunded (3 08)
	42' - 3/4" copper tubing @ .3629	15 24			NON CHARGE 21 92
	1 - 3/4" C x 1/2" I.W.H. stop & waste	4 00		12/31/53	Labor 1 75
	1 - hr. trucking		75	23' - 3/4" copper tubing @ .3629	9 35
			21 92	1 - 3/4" C. curb-cock	4 33
				1 - 3/4" C x 3/4" C. curb-cock	4 67
				1 box and rod	3 90
				1 - 1/2" straight tail pc.	50
				1 - 1/2" offset tail pc.	50
				1 hr. trucking	75
					<u>24 75</u>

DATE \_\_\_\_\_

TOWN OF LEXINGTON — BOARD OF PUBLIC WORKS  
WATER DIVISION

Sketch of Service Here

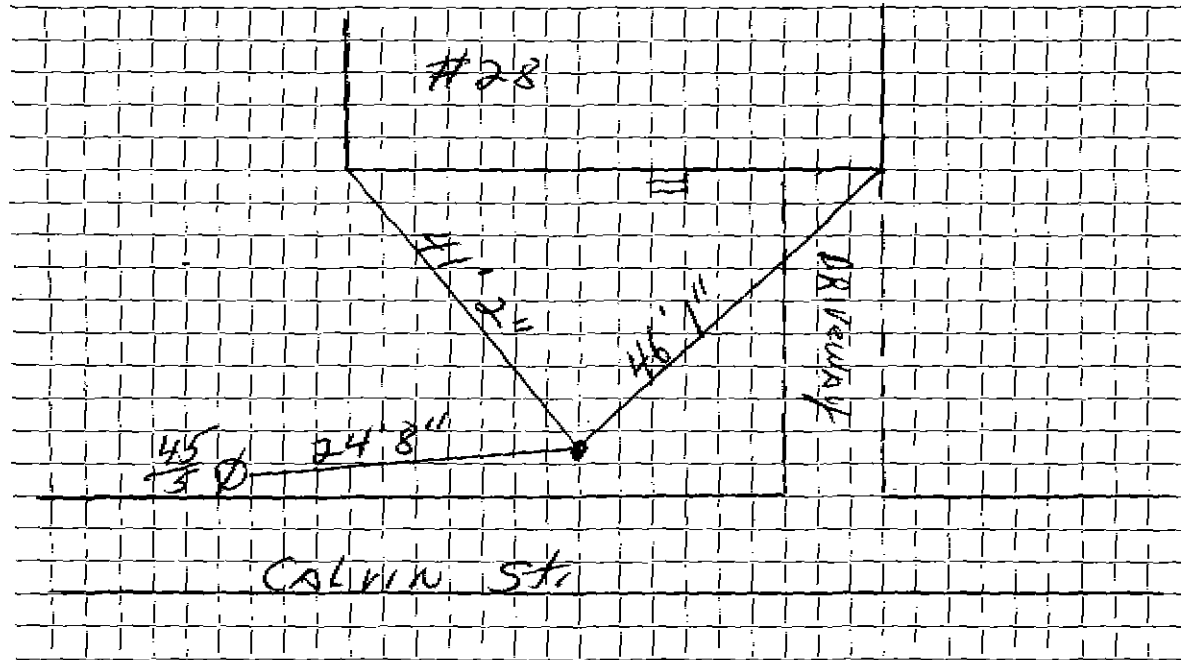

Connection made in ..... Street. Work completed .....

Remarks: .....  
.....  
.....