


DATE 8/18/18
8/2017

TOWN OF LEXINGTON — BOARD OF PUBLIC WORKS

WATER DIVISION

Sketch of Service Here

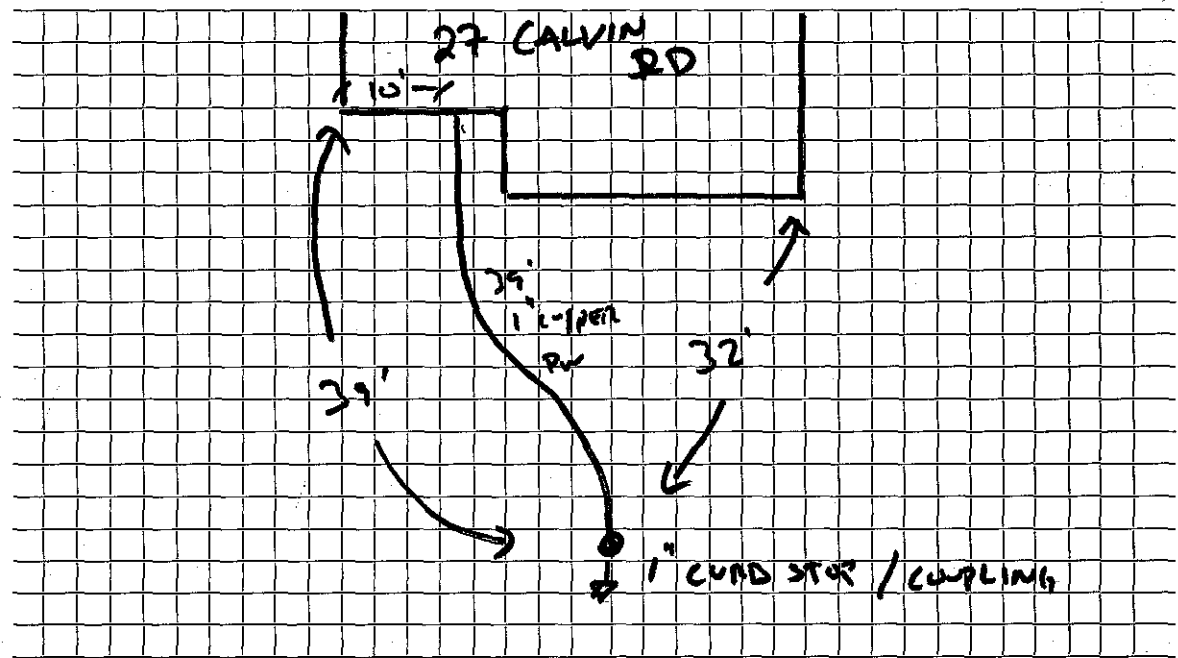

Connection made in CALVIN Street. Work completed MCLAUGHLIN

Remarks: Replaced old 3/4" CURB