

WATER SERVICE RECORD

Name William H. Sullivan

Service No. 243

Address 29 Calvin Street

Location

~~REPAIR WORK~~ - New Service

Comm. 11-8-54


Date	Material	Amount	Total	Date	Amount
10/13/54	Labor	1 85		9-29-54	Deposited 25 00
	10% overhead	19	2 04	11-8-54	Refunded (3 16)
	43' - 3/4" copper tubing @ .35		15 05		<u>NON CHARGE</u> 21 84
	1 - 3/4" C x 1/2 I.W.H. stop & waste		4 00		OLD SERVICE WAS IN TO CURB:
	1 hr. trucking		75	1 - 1/2	offset tail piece 50
			21 84	1 - 1/2	straight tail piece 50
					<u>1 00</u>
				4/30/49	
				10	3/4 COPPER
					3/4 CORP
					3/4 CURB STOP
					Box & Rod

DATE _____

TOWN OF LEXINGTON — BOARD OF PUBLIC WORKS

WATER DIVISION

Sketch of Service Here

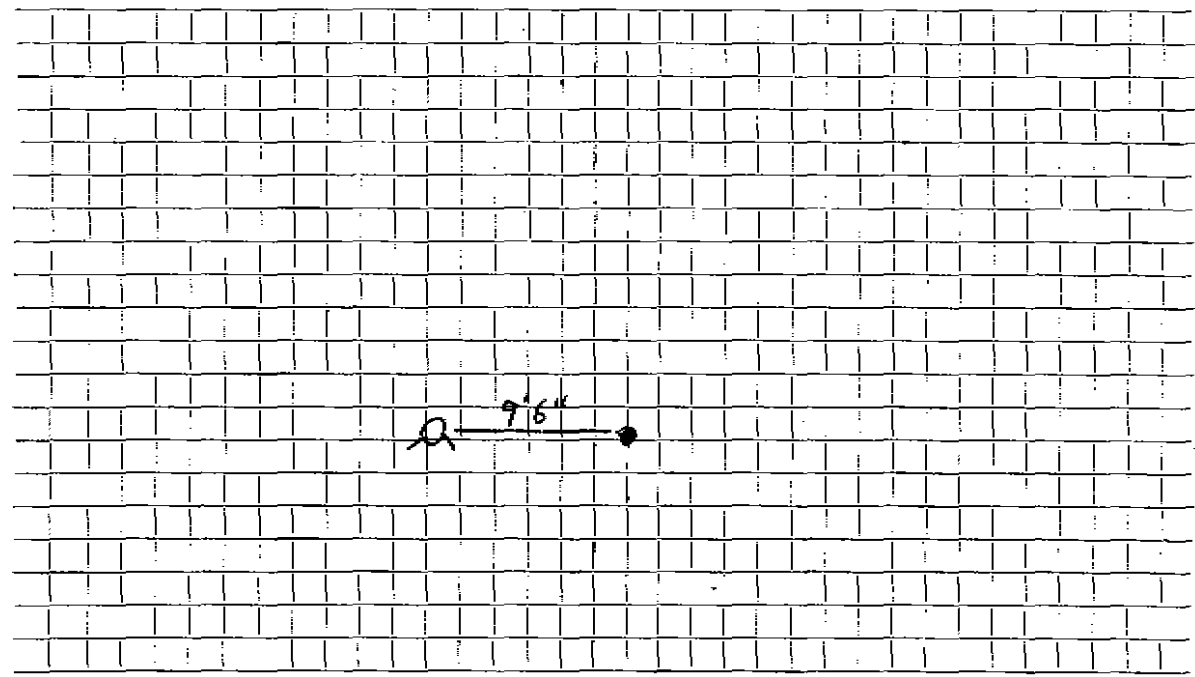

Connection made in Street. Work completed

Remarks:
.....
.....