

WATER SERVICE RECORD

Name Rose DiFranco

Service No. 402 (1933)

Address 30 Calvin Street

Location


~~Repair~~ Renewal—New Service 30M. 1-18-54

Date	Material	Amount	Total	Date	Amount
1/4/54	Labor	1 75		12-22-53	Deposited 25 00
	10% overhead	18	1 93	1-18-54	Refunded (2 35)
	44' - 3/4" copper tubing @ .3629	15 97			<u>MOM CHARGE</u> 22 65
	1 - 3/4" C x 1/2 I.E.H. stop waste	4 00		1/4/54	Labor 1 75
	1 hr. trucking		75		21' - 3/4" copper tubing @ .3629 7 62
			22 65		1 - 3/4" C. curb-cock 4 33
					1 - 3/4" C x 3/4" C. curb-cock 4 67
					1 box and rod 3 90
					1 - 1/2 offset tail pc. 50
					1 - 1/2 straight tail pc. 50
					1 hr. trucking 75
					<u>24 02</u>

DATE _____

TOWN OF LEXINGTON — BOARD OF PUBLIC WORKS
WATER DIVISION

Sketch of Service Here

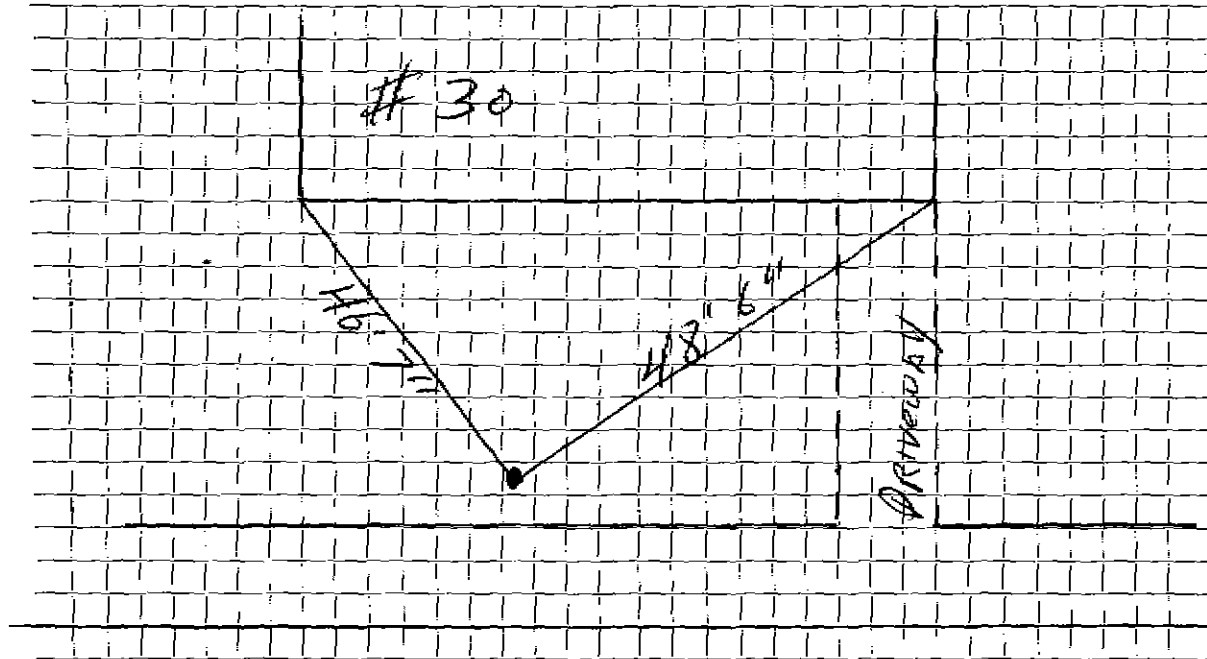

Connection made in Street. Work completed

Remarks:

.....
.....