

WATER SERVICE RECORD

Name William H. Sullivan

Service No. 234

Address 31 Calvin Street

Location

Repair Renew New Service

Com. 11-8-54


Date	Material	Amount	Total	Date	Amount
9/30/54	Labor	1 90		9-10-54 Deposited	25 00
	10% Overhead	19	2 09	11-8-54 Refunded	(4 86)
	38' - 3/4" Copper tubing @ .35		13 30	<u>NON CHARGE</u>	20 14
	1 - 3/4" C x 1/2 I.W.H. stop & waste		4 00	9/30/54 Labor	1 90
	1 hr. trucking		75	10/1/54 Labor	22 13
			20 14	50' - 3/4" Copper tubing @ .35	17 50
				1 - 3/4" C. corp-cock	4 33
				1 - 3/4" C x 3/4" C. curb-cock	4 67
				1 box and rod	3 90
				1 - 1/8 straight tail piece	50
				1 - 1/8 offset tail piece	50
				1 hr. town shovel @ 5.00	5 00
				1 hr. trucking	75
					<u>61 18</u>

DATE _____

TOWN OF LEXINGTON — BOARD OF PUBLIC WORKS

WATER DIVISION

Sketch of Service Here

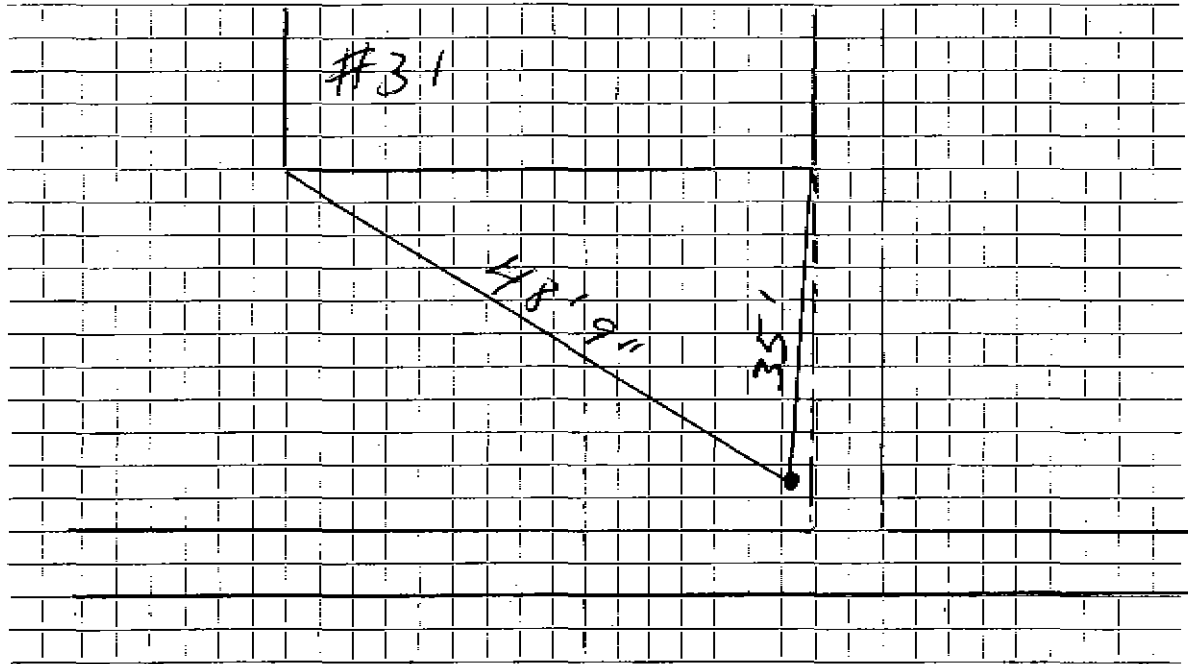

Connection made in Street. Work completed

Remarks:
.....
.....