

WATER SERVICE RECORD

5304
5305

Name John Anderson

Service No. 108

Address 34 Calvin Street

Location

~~REPAIR WORK~~ New Service

COM. 7-19-54

Date	Material	Amount	Total	Date	Amount
6/1/54	Labor	1 85		5-17-54 Deposited	25 00
	10% overhead	19	2 04	7-20-54 Refunded	5 61
	36' - 3/4" copper tubing @.35		12 60		<u>19 39</u>
	1 - 3/4"C x 1/2 I.W.H. stop & waste	4 00		6/2/54 Labor	20 30
	1 hr. trucking		75	70' - 3/4" copper tubing@.35	24 50
			19 39	1 - 3/4"C. corp-cock	4 33
				1 - 3/4"C x 3/4"C. curb-cock	4 67
				1-3/4" union	1 72
				1 box and rod	3 90
				1 - 1/2 offset tail pc.	50
				1 - 1/2 straight tail pc.	50
				2 hrs. town shovel @ 5.00	10 00
				1 hr. trucking	75
					<u>71 17</u>

DATE _____


TOWN OF LEXINGTON — BOARD OF PUBLIC WORKS

WATER DIVISION

82 Feb 14 51

Sketch of Service Here

741

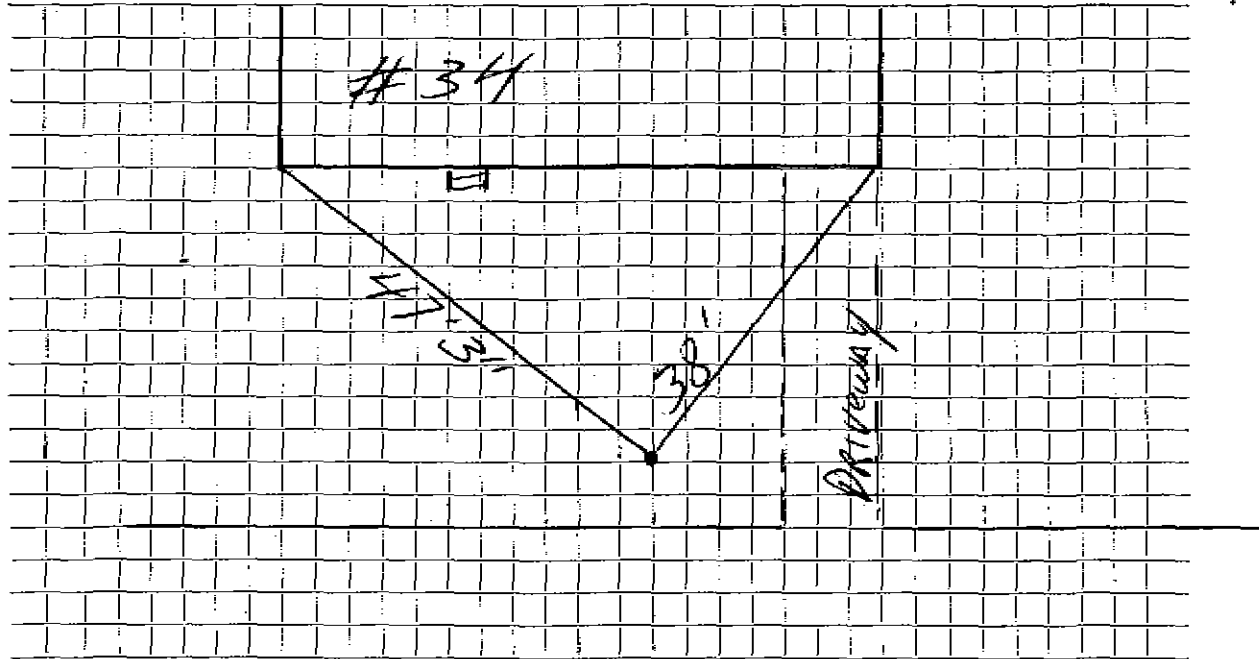

Connection made in Street. Work completed

Remarks:
.....
.....