

WATER SERVICE RECORD

Name Charles E. Murray

Service No. 126

Address 5 Calvin Street

5778

Location Lexington

~~Repair/Replacement~~ - New Service

Conn. 8-10-53

Date	Material	Amount	Total	Date	Amount
6/26/53	Labor	1 75		6-5-53	Deposited 25 00
	10% overhead	18	1 93	8-10-53	* Refunded (4 53)
	38' 3/4" Copper Tubing @ .3629		13 79		NON CHARGE 20 47
	1-3/4" C x 1/8" I.W.E. STOP & WASTE		4 00	6/26/53	Labor 1 75
	1 Hr. Trucking		75		36' 3/4" Copper Tubing @ .3629 13 06
			20 47		1-3/4" C. Corp-cock 4 33
					1-3/4" C x 3/4" C. Corb-cock 4 67
					1-Box & Rod 3 90
					1-1/2" offset tail piece 50
					1-5/8" straight tail piece 50
					1 Hr. Trucking 75

29 45


* \$141 of this refund made payable to town to apply on bal. due on S.H.C. #112

DATE _____

TOWN OF LEXINGTON — BOARD OF PUBLIC WORKS

WATER DIVISION

Sketch of Service Here

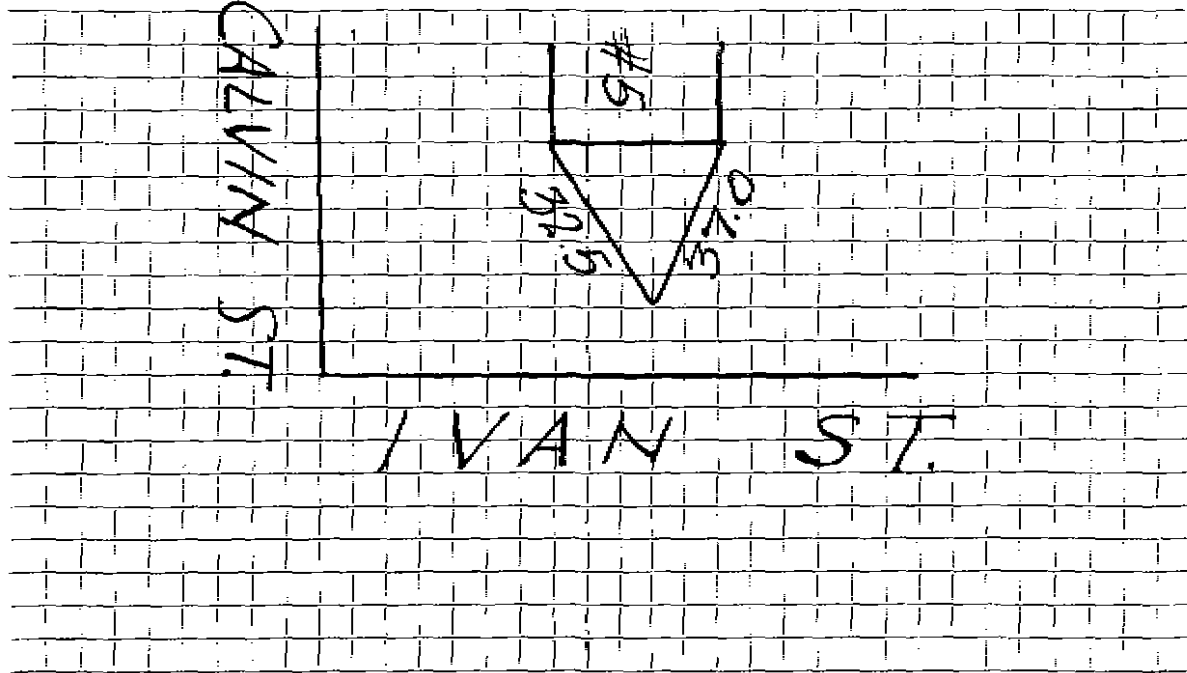

Connection made in Street. Work completed

Remarks:
.....
.....