

Name Neil McIntosh

Service No. ~~448~~ <sup>203</sup> 448

Address 24 Meriam St.  
6 Calvin St.

Location 1st house, Calvin St. #6

Kind of Pipe

Size

Size of Main

~~Repair-Renewal~~ New Service

Location

Date	Material	Amount	Total	Date	Amount
Can. 29-70	35 1" C.L. Pipe @ .27	9 45			
8-4-31	2 1" L.L. Coupl. @ .30	60			
	2 1" L.L. Ell	35			
	1 1" Br. Sp. Pip.	25			
	1 S.F.	3 00			
	Trucking	75	14 40		
10/31	7 Hrs. Labor @ .55	3 85			
	3 " " @ .60	1 80	5 65		
	15% Overhead		85		
			20 90		
	<b>Labor</b>				
	<b>CHARGE</b>				
	35 ft. @ .75 pr.ft.	\$26 25			
	Water from hydrant	3 00	\$29 75		

Aug. 12 1931 - Cash

29 25

Hadley Press, Inc., Lexington

DATE \_\_\_\_\_

# TOWN OF LEXINGTON - BOARD OF PUBLIC WORKS

## WATER DIVISION

The undersigned applies for a supply of water at No. Calvin St. and hereby agrees to comply with the rules and regulations as now, or at any future time, established by the Board of Selectmen.

Am't. of Estimate \$ \_\_\_\_\_

Owner

Paul A. Sutok


Am't. Paid \$ \_\_\_\_\_

Address

24 Ocean St  
Lexington

Builder \_\_\_\_\_

Sketch of Service Here

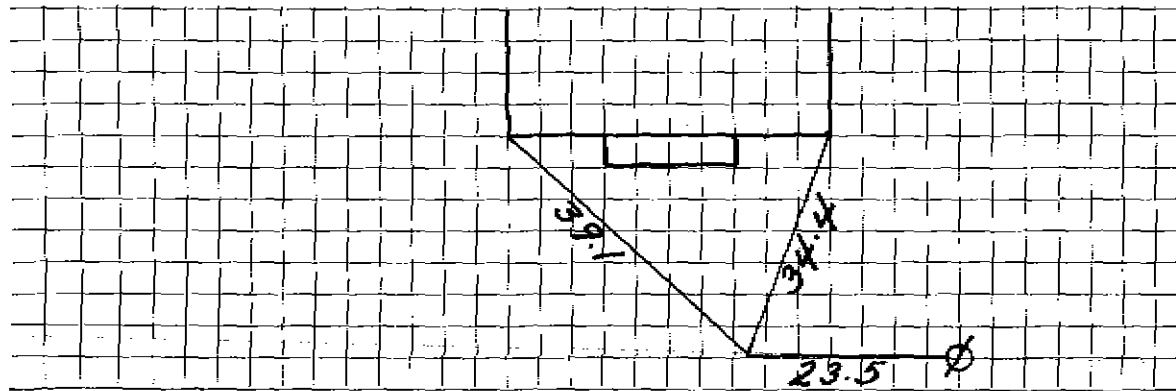

Connection made in \_\_\_\_\_ Street.

Work completed \_\_\_\_\_ 19

Remarks: